

Harrison
 L 523
 11/10/78

MISSISSIPPI
 BOARD OF WATER COMMISSIONERS
 416 North State Street
 Jackson, Mississippi 39201

CODED

WATER WELL DRILLERS LOG

11/10/78 19 date well completed
 Coastal Drilling firm name
 Harrison county well located

LANDOWNER: Dr. Perkins
Lampson Rd.
Ypt Miss
 (mailing address)

description of formations encountered	from	to
Top Soil	1	5
Red Clay	5	25
Coarse white Sand	25	40
Seagrass Sand	40	65
Soft Red Clay	65	85
Soft Blue Clay	85	310
fine water sand	310	360
Hard Blue Clay	360	570
fine water sand	570	570
Coarse white Sand	570	575

WELL LOCATION:
 sec 2 T 7 N R 11 E ?
(2) 70 S. W. Lymon
 (distance) miles (direction) (nearest town)

WELL PURPOSE: home
 (home, irrigation, municipal, industrial)

- WELL COMPLETION DATA:
- (1) diameter (inches) 4 1/2"
 - (2) total depth (feet) 575'
 - (3) static water level (feet) 60 below above top of ground.
 - (4) casing PVC 560'
 (material) (depth)
4 1/2" (size) if telescope see back.
 - (5) screen 15' 560'
 (length) (depth to top)
2" (size) PVC (material)
 - (6) pump 2 HP 30
 (HPT) (yield gpm)
9 hp sub (type power)
 - (7) electric log no
 (yes or no)
- (organization running log)

(8) how well bottom plugged
2" backwash valve

DRILLERS REMARKS:

CODED

Miss. Board of Water Comm.


APR 23 1979

RECEIVED

If well telescopes please sketch and show depths.

GROUND LEVEL

200ft 4" PVC
Casing

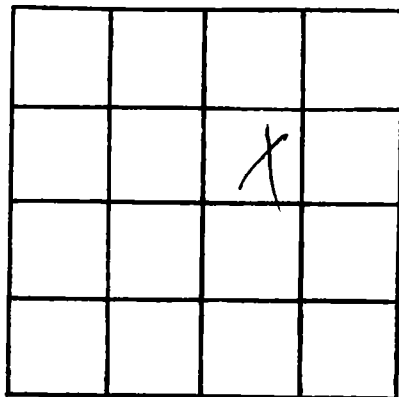

SECTION _____

Please indicate well location X.

ADDITIONAL INFORMATION

360' 2" PVC
Casing

15' 2" PVC Screen

2" backwash Valve
19-B

If more than one screen,
show locations of each on sketch.