

HARRISON  
 L 526  
 11-29-78

MISSISSIPPI  
 BOARD OF WATER COMMISSIONERS  
 416 North State Street  
 Jackson, Mississippi 39201

CODED

WATER WELL DRILLERS LOG

11/29/78 19 Coastal Drilling Harrison  
 date well completed firm name county well located

LANDOWNER: Albert Hampton

description of formations encountered

from to

Rt 3 Box 563 E

Top Soil

3 3

apt. in  
 (mailing address)

Red Clay

3 15

WELL LOCATION:

Coarse white Sand

15 25

sec. 6 T. 7 N R. 11 E

Sugar Sand

25 70

(3) three miles North of London  
 (distance) (direction) (nearest town)

Soft Red Clay

70 115

WELL PURPOSE:

Sugar Sand

115 160

(home, irrigation, municipal, industrial)

Coarse white Sand

160 280

WELL COMPLETION DATA:

Hard Blue Clay

280 490

(1) diameter (inches) 4 1/2"

fine water sand

490 550

(2) total depth (feet) 550'

(3) static water level (feet) 60 below top of ground.

CODED

(4) casing PVC 535' (material) (depth)

4 1/2" (size) If telescope see back.

(5) screen 15' 535' (length) (depth to top)

2" (size) PVC (material)

(6) pump one 15 (HP) (yield gpm)

5 hp (type power)

(7) electric log yes (yes or no)

(organization running log)

(8) how well bottom plugged 30' back with gravel

DRILLERS REMARKS:

Miss. Board of Water Comm.

APR 23 1979

RECEIVED



If well telescopes please sketch and show depths.

02000

**GROUND LEVEL**

horizontal flow

14000

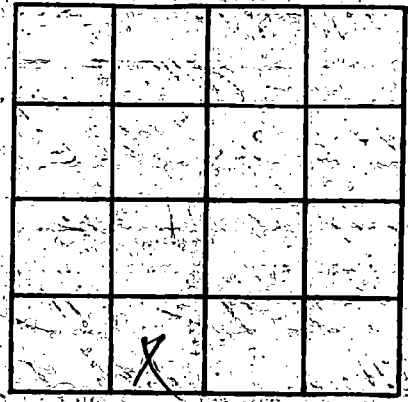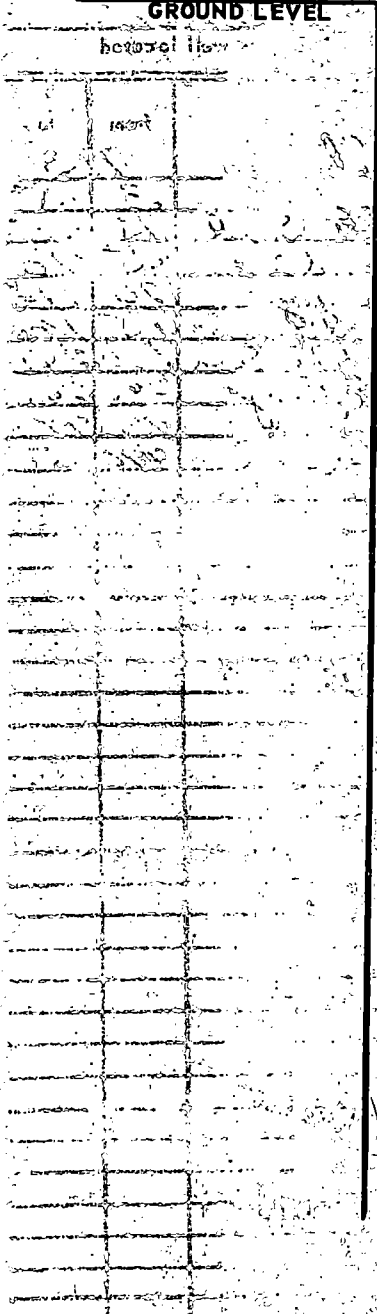

SECTION \_\_\_\_\_

Please indicate well location X.

**ADDITIONAL INFORMATION**

Multiple horizontal lines for providing additional information.

If more than one screen, show locations of each on sketch.