

HARRISON

L 527

09-25-78

MISSISSIPPI BOARD OF WATER COMMISSIONERS
416 North State Street
Jackson, Mississippi 39201

CODED

WATER WELL DRILLERS LOG

9/25/78
date well completed

19 Coastal Drilling
Bilal's Inc
firm name

Harrison
county well located

LANDOWNER: George Brown

description of formations encountered

from to

Car Wash

top soil

1 2

404 Min
(mailing address)

Red Clay

2 20

WELL LOCATION:

sec 9 T 7 N R 11 E
S W

Coarse white sand

20 35

Sugar sand

35 60

Soft Blue Clay

60 210

fine water sand

210 240

hard blue clay

240 460

fine water sand

460 510

good water sand

510 550

WELL PURPOSE: Car Wash
(home, irrigation, municipal, industrial)

WELL COMPLETION DATA:

CODED

- (1) diameter (inches) 4 1/2"
- (2) total depth (feet) 550'
- (3) static water level (feet) 40 below top of ground

- (4) casing PVC 535'
(material) (depth)
- 4 1/2"
(size) if telescope see back.

- (5) screen 15' 535'
(length) (depth to top)
- 2" PVC
(size) (material)

- (6) pump 2 HP 35
(HP) (yield gpm)
- Electric
(type power)

- (7) electric log no
(yes or no)

(organization running log)

- (8) how well bottom plugged
2" hole with valve

DRILLERS REMARKS:

Miss. Board of Water Comm.

APR 28 1979

RECEIVED

If well telescopes please sketch and show depths.

GROUND LEVEL


200ft 4" PVC
Casing

335' 2" PVC
Casing

15ft 2" PVC screen

2" back wash valve

If more than one screen, show locations of each on sketch.

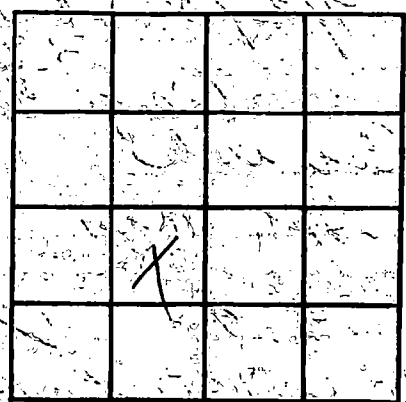

SECTION _____

Please indicate well location X.

ADDITIONAL INFORMATION

Lined area for additional information.