

HARRISON

L 528

4-6-79

MISSISSIPPI BOARD OF WATER COMMISSIONERS  
416 North State Street  
Jackson, Mississippi 39201

CODED

WATER WELL DRILLERS LOG

April 6

date well completed

1979 *Sumcon Well Drilling*

firm name

*Harrison*

county well located

LANDOWNER: *Beatline Tuesday*

Description of formations encountered

from

to

*Beatline Rd.*

*TOP SAND*

*0 30*

*Long Beach, Miss.*

(mailing address)

*White Clay*

*30 80*

*Blue Clay*

*80 400*

*Green Sand*

*400 460*

*Coarse Sand*

*460 480*

WELL LOCATION:

sec *33* T *8* R *12*

*3* miles *N.E.* of *Long Beach*

(distance) (direction) (nearest town)

WELL PURPOSE: *Industrial*  
(home, irrigation, municipal, industrial)

WELL COMPLETION DATA:

CODED

(1) diameter (inches) *2"*

(2) total depth (feet) *482'*

(3) static water level (feet) *18'* *below* top of ground.

(4) casing *PVC*, *472'*  
(material) (depth)

*—* If telescope see back.  
(size)

(5) screen *10'*, *472'*  
(length) (depth to top)

*2"*, *PVC*  
(size) (material)

(6) pump *1*, *12*  
(HP) (yield gpm)

*Electric*  
(type power)

(7) electric log (yes or no)

(organization running log)

(8) how well bottom plugged *Good*

Miss. Board of Water Comm.


JUN - 5 1979

DRILLERS REMARKS:

RECEIVED

If well telescopes please sketch and show depths.

GROUND LEVEL

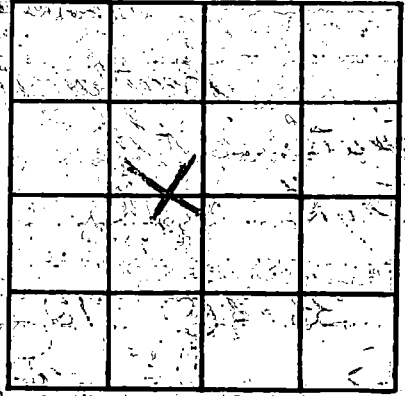

SECTION 33

Please indicate well location X.

ADDITIONAL INFORMATION

If more than one screen, show locations of each on sketch.