

HARRISON
L 530
3-1-79

MISSISSIPPI
 BOARD OF WATER COMMISSIONERS
 416 North State Street
 Jackson, Mississippi 39201

CODED

WATER WELL DRILLERS LOG

March 1 1979 Duncan Well Drilling Harrison
 date well completed firm name county well located

LANDOWNER: M. M. Vaughan
1233 - 24th St.
Gulfport, Ms 39501
 (mailing address)

description of formations encountered
Sand
 from 0 to 30

WELL LOCATION:
 sec. 35 T. 7 N. R. 11
In town (distance) of Gulfport (direction) (nearest town)

WELL PURPOSE: Law
 (home, irrigation, municipal, industrial)

CODED

- WELL COMPLETION DATA:
- (1) diameter (inches) 2"
 - (2) total depth (feet) 30'
 - (3) static water level (feet) 3' below top of ground.
 - (4) casing PVC 20'
 (material) (depth)
 - (size) If telescope see back.
 - (5) screen 10' 20'
 (length) (depth to top)
2" PVC
 (size) (material)
 - (6) pump 1/2 12
 (HP) (yield gpm)
electric
 (type power)
 - (7) electric log _____
 (yes or no)
 - (organization running log) _____
 - (8) how well bottom plugged Cap

DRILLERS REMARKS:

Miss. Board of Water Comm.

FORM - 5 10/79


REGISTERED

If well telescopes please sketch and show depths.

GROUND LEVEL

A large grid for sketching well telescopes and depths. The grid is composed of horizontal and vertical lines forming a series of squares. The top of the grid is labeled "GROUND LEVEL". There are some faint handwritten markings in the top left corner of the grid, including "DE" and "3".

If more than one screen, show locations of each on sketch.

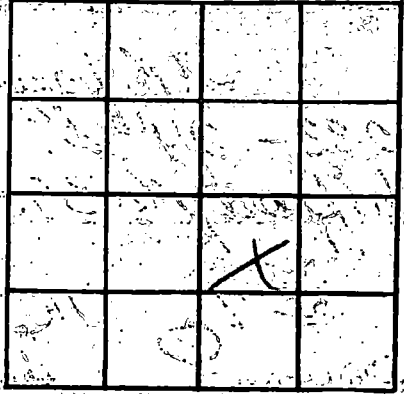

SECTION 35

Please indicate well location X:

ADDITIONAL INFORMATION

A series of horizontal lines for additional information. The lines are evenly spaced and extend across the width of the page. There are approximately 15 lines in total.