

HARRISON
L 542
4/22/78

**MISSISSIPPI  
BOARD OF WATER COMMISSIONERS**  
416 North State Street  
Jackson, Mississippi 39201

**CODED**

**WATER WELL DRILLERS LOG**

April 22 1978 Mississippi Well Drillers Harrison  
 date well completed firm name county well located

LANDOWNER: <u>Mrs. Toupe</u>	description of formations encountered	from	to
<u>1623-3200E</u>	<u>sand</u>	<u>0</u>	<u>30</u>
<u>Get. MS.</u> (mailing address)			
<b>WELL LOCATION:</b> sec. <u>34</u> T <u>7</u> N R <u>11</u> E <u>2</u> miles <u>E</u> of <u>Get.</u> (distance) (direction) (nearest town)			
<b>WELL PURPOSE:</b> (home, irrigation, municipal, industrial)	<b>CODED</b>		
<b>WELL COMPLETION DATA:</b>			
(1) diameter (inches) <u>2"</u>			
(2) total depth (feet) <u>30</u>			
(3) static water level (feet) <u>4'</u> <u>below</u> top of ground.			
(4) casing <u>sch 40</u> <u>20'</u> (material) (depth) <u>-</u> (size) if telescope see back.			
(5) screen <u>10'</u> <u>-</u> (length) (depth to top) <u>2"</u> <u>plastic</u> (size) (material)			
(6) pump <u>1/2</u> <u>15</u> (HP) (yield gpm) <u>electric</u> (type power)			
(7) electric log <u>no</u> (yes or no) <u>-</u> (organization running log)			
(8) how well bottom plugged <u>cased</u>			
<b>DRILLERS REMARKS:</b>			


Miss. Board of Water Comm.

AUG 27 1979

**RECEIVED**

If well telescopes please sketch and show depths.

GROUND LEVEL

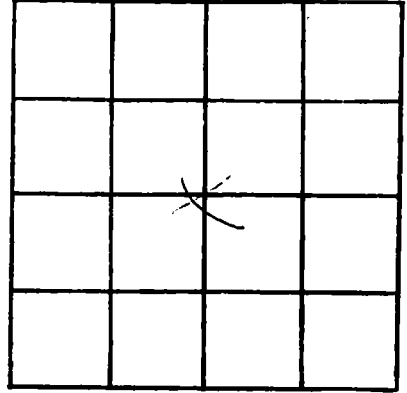

SECTION 32

Please indicate well location X.

ADDITIONAL INFORMATION

If more than one screen, show locations of each on sketch.