

HARRISON
2549
06-30-79

MISSISSIPPI
BOARD OF WATER COMMISSIONERS
416 North State Street
Jackson, Mississippi 39201

CODED

WATER WELL DRILLERS LOG

June 30 1979 date well completed
Duncowell Drilling Harrison firm name
Harrison county well located

LANDOWNER: J. B. Benheim
906 E. Beach
Sulphur, Mo.
(mailing address)

description of formations encountered	from	to
	Sand	0

WELL LOCATION:
sec. 3 T 8 N R 11 E S W
On Sulphur
(distance) (direction) (nearest town)

WELL PURPOSE: drinking
(home, irrigation, municipal, industrial)

CODED

- WELL COMPLETION DATA:
- (1) diameter (inches) 2"
 - (2) total depth (feet) 334'
 - (3) static water level (feet) 2' ^{below} top of ground
 - (4) casing PVC 23'
(material) (depth)
 - (5) screen 10' 23'
(length) (depth to top)
 - (6) pump 2" PVC
(size) (material)
 - (7) pump 1/2 12
(HP) (yield gpm)
 - (8) pump electric
(type power)
 - (9) electric log yes or no
 - (10) organization running log _____
 - (11) how well bottom plugged Cap

DEPT. OF NATURAL RESOURCES
BUREAU OF LAND & WATER RESOURCES


JAN 15 1980

DRILLERS REMARKS:

RECEIVED

If well telescopes please sketch and show depths.

GROUND LEVEL

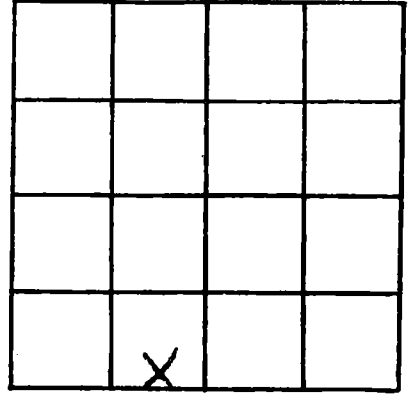

SECTION 3

Please indicate well location X.

ADDITIONAL INFORMATION

-If more than one screen,
show locations of each on sketch.