

HARRISON  
L 551  
06-30-79

MISSISSIPPI  
 BOARD OF WATER COMMISSIONERS  
 416 North State Street  
 Jackson, Mississippi 39201

CODED

WATER WELL DRILLERS LOG

date well completed June 30 1979 firm name Suncor Well Drilling county well located Harrison

LANDOWNER Larry McKay description of formations encountered from to  
2nd St.  
Gulfport, Ms. Sand 0 30  
 (mailing address)

WELL LOCATION:  
 sec. 3 T. 8 N. R. 11 E.  
In Gulfport  
 (distance) (direction) (nearest town)

CODED

WELL PURPOSE: irrigation  
 (home, irrigation, municipal, industrial)

- WELL COMPLETION DATA:
- (1) diameter (inches) 2"
  - (2) total depth (feet) 30 ft.
  - (3) static water level (feet) 3' below above top of ground.
  - (4) casing PVC, 20'  
 (material) (depth)  
         If telescope see back.  
 (size)
  - (5) screen 10', 20'  
 (length) (depth to top)  
2", PVC  
 (size) (material)
  - (6) pump \_\_\_\_\_ (HP) \_\_\_\_\_ (yield gpm)  
 (type power)
  - (7) electric log \_\_\_\_\_ (yes or no)  
 (organization running log)
  - (8) how well bottom plugged Cp

DRILLERS REMARKS: Owner  
install & test  
own pump


DEPT. OF NATURAL RESOURCES  
 BUREAU OF LAND & WATER RESOURCES

JAN 15 1980

RECEIVED

If well telescopes please sketch and show depths.

GROUND LEVEL

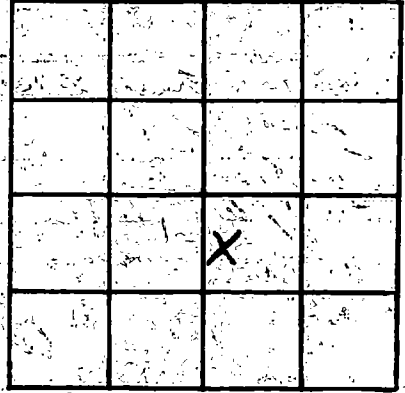

SECTION 3

Please indicate well location X.

ADDITIONAL INFORMATION

If more than one screen, show locations of each on sketch.