

HARRISON
 L 552
 08-15-79

MISSISSIPPI
 BOARD OF WATER COMMISSIONERS
 416 North State Street
 Jackson, Mississippi 39201

CODED

WATER WELL DRILLERS LOG


Aug. 15 1979 Kumac Well Drilling Harrison
 date well completed firm name county well located

LANDOWNER: <u>Edgar L. Linder</u> <u>Pass Road</u> <u>Georgetown</u> (mailing address)	description of formations encountered	from to
	<u>Sand</u>	<u>0 28</u>
CODED		
WELL LOCATION: sec <u>7</u> T <u>7</u> N <u>5</u> R <u>11</u> E <u>W</u> <u>In town</u> <u>Handboro</u> (distance) (direction) (nearest town)		
WELL PURPOSE: <u>Drain</u> (home, irrigation, municipal, industrial)		
WELL COMPLETION DATA:		
(1) diameter (inches) <u>2"</u>		
(2) total depth (feet) <u>28 ft</u>		
(3) static water level (feet) <u>2'</u> <u>below</u> above top of ground.		
(4) casing <u>PVC</u> , <u>18'</u> (material) (depth)		
<u> </u> If telescope see back. (size)		
(5) screen <u>10'</u> , <u>18'</u> (length) (depth to top)		
<u>2"</u> , <u>PVC</u> (size) (material)		
(6) pump <u>1/2</u> , <u>14</u> (HP) (yield gpm)		
<u>electric</u> (type power)		
(7) electric log <u> </u> (yes or no)		
<u> </u> (organization running log)		
(8) how well bottom plugged <u>Cap</u>		
DRILLERS REMARKS: <u> </u>		

DEPT. OF NATURAL RESOURCES
 BUREAU OF LAND & WATER RESOURCES
 JAN 14 1980
 RECEIVED

If well telescopes please sketch and show depths.

GROUND LEVEL

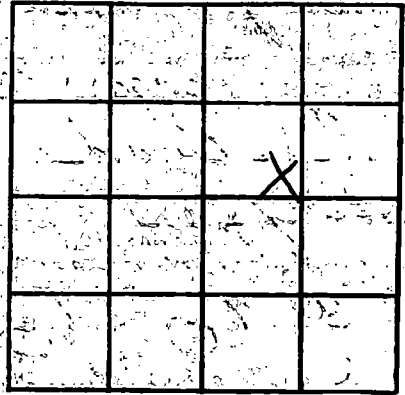

SECTION 30

Please indicate well location X.

ADDITIONAL INFORMATION

If more than one screen, show locations of each on sketch.