

HARRISON

MISSISSIPPI
BOARD OF WATER COMMISSIONERS
416 North State Street
Jackson, Mississippi 39201

CODED

WATER WELL DRILLERS LOG

6-20-80
6/20/80
date well completed

Lyman Well Co.
firm name

Harrison
county well located

LANDOWNER: H.L. Grimes
RT 9 Box 130
Gulfport, MS 39501
(mailing address)

description of formations encountered	from	to
white sand	0	12
blue cat geyclay	12	112
fine sand	112	215

WELL LOCATION:
sec. 22 T 1 N R 11 E
1/2 miles N of Gulfport
(distance) (direction) (nearest town)

WELL PURPOSE: home
(home, irrigation, municipal, industrial)

WELL COMPLETION DATA:

- (1) diameter (inches) 2"
- (2) total depth (feet) 225'
- (3) static water level (feet) 9 ^{below} above top of ground
- (4) casing PVC, 215' (material) (depth)
2in (size) if telescope see back.
- (5) screen 10', 215' (length) (depth to top)
2" 8 slot PVC (size) (material)
- (6) pump 1 (HP) 18 (yield gpm)
electric (type power)
- (7) electric log No (yes or no)
No (organization running log)
- (8) how well bottom plugged sand
shark

CODED

DEPT. OF NATURAL RESOURCES
BUREAU OF LAND & WATER RESOURCES


JUN 26 1980

DRILLERS REMARKS:

RECEIVED

If well telescopes please sketch and show depths.

GROUND LEVEL

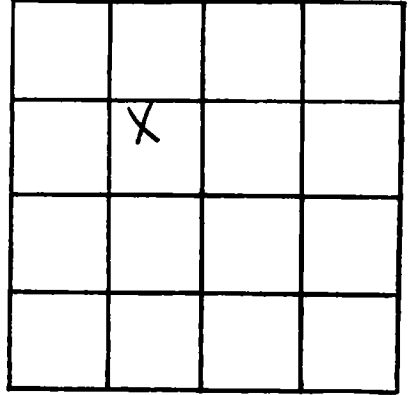

SECTION 22

Please indicate well location X.

ADDITIONAL INFORMATION

If more than one screen, show locations of each on sketch.