

HARRISON
L 568
8-7-80

MISSISSIPPI
 BOARD OF WATER COMMISSIONERS
 416 North State Street
 Jackson, Mississippi 39201

CODED

WATER WELL DRILLERS LOG

8-7-80 date well completed Muncie Well Drilling firm name Harrison county well located

LANDOWNER: A. D. Burns
600 Broad Ave
Gulfport Ms
 (mailing address)

description of formations encountered	from	to
<u>sand</u>	<u>0</u>	<u>30</u>

WELL LOCATION:
 sec. 6 T 8 N R 11 E
In city of Gulfport
 (distance) miles (direction) of (nearest town)

CODED		
--------------	--	--

WELL PURPOSE: Drum
 (home, irrigation, municipal, industrial)

- WELL COMPLETION DATA:
- (1) diameter (inches) 2"
 - (2) total depth (feet) 30 ft
 - (3) static water level (feet) 0 below top of ground.
 - (4) casing PVC, 30'
 (material) (depth)
 - _____ if telescope see back.
 (size)
 - (5) screen 10' 20'
 (length) (depth to top)
2" PVC
 (size) (material)
 - (6) pump 1/2 12
 (HP) (yield gpm)
electric
 (type power)
 - (7) electric log _____
 (yes or no)


 (organization running log)
 - (8) how well bottom plugged Cap

CODED		
DEPT. OF NATURAL RESOURCES BUREAU OF LAND & WATER RESOURCES		
OCT 31 1980		
RECEIVED		

DRILLERS REMARKS: _____

03009
If well telescopes please sketch and show depths.

GROUND LEVEL

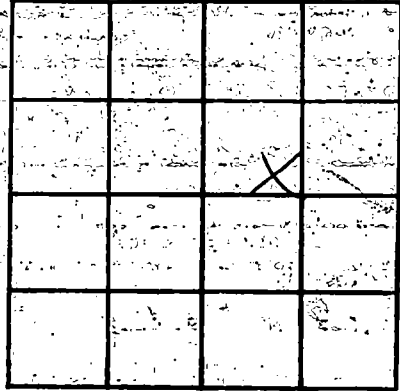

SECTION 6

Please indicate well location X.

ADDITIONAL INFORMATION

If more than one screen, show locations of each on sketch.