

MISSISSIPPI DEPARTMENT OF NATURAL RESOURCES

Bureau of Land and Water Resources

Southport Mall

P.O. Box 10631

CODE

Jackson, Mississippi 39209

WATER WELL DRILLERS LOG

COASTAL DRILLING & SERVICE CO.

ROUTE 1 BOX 618

Hamilton county well located

HARRISON
L 570

7-21-80
7/21/80

date well completed

LANDOWNER

Camel Road

444 Min

(mailing address)

WELL LOCATION:

sec 6 T 9 N R 11 E W

(3) NW Jordan

(distance) miles (direction) (nearest town)

WELL PURPOSE:

(home, irrigation, municipal, industrial)

WELL COMPLETION DATA:

- (1) diameter (inches) 2"
- (2) total depth (feet) 525'
- (3) static water level (feet) 50' below above top of ground.
- (4) casing PVC 515'
(material) (depth)

(size) if telescope see back.

- (5) screen 10' 515'
(length) (depth to top)
- 2" PVC
(size) (material)

- (6) pump one 12
(HP) (yield gpm)

ele
(type power)

- (7) electric log no
(yes or no)

(organization running log)

- (8) how well bottom plugged

2' from well bottom

DRILLERS REMARKS:

BILOXI, MISS. 39537

description of formations encountered

from to

top soil	1	3
Red Clay	3	30
Sand	30	70
Coarse white sand	70	120
Soft Blue Clay	120	200
Coarse white sand	200	240
Soft Blue Clay	240	320
Hard Blue Clay	320	420
fine white sand	420	490
Coarse white sand	490	525


CODED

DEPT. OF NATURAL RESOURCES
BUREAU OF LAND & WATER RESOURCES

JAN 23 1981
RECEIVED

If well telescopes please sketch and show depths.

GROUND LEVEL

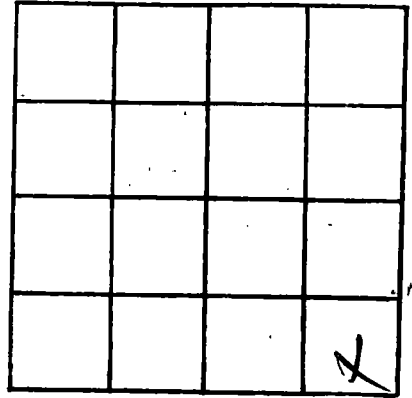

SECTION _____

Please indicate well location X.

ADDITIONAL INFORMATION

If more than one screen,
show locations of each on sketch.