

MISSISSIPPI DEPARTMENT OF NATURAL RESOURCES

Bureau of Land and Water Resources

Southport Mall

P.O. Box 10631

Jackson, Mississippi 39209

WATER WELL DRILLERS LOG

CODED

HARRISON
L 572
11/18/80
11-18

date well completed

19

80 Duncan Well Drilling

firm name

Harrison
county well located

LANDOWNER:

Jay Hill

description of formations encountered

from

to

Hytter Rd.

Dpt. Ms.

(mailing address)

<u>Sand</u>	<u>0</u>	<u>65</u>
<u>White Clay</u>	<u>65</u>	<u>103</u>
<u>Blue Clay</u>	<u>103</u>	<u>380</u>
<u>Fine Sand</u>	<u>380</u>	<u>395</u>
<u>Course SAND</u>	<u>395</u>	<u>410</u>

WELL LOCATION:

sec. 13 T. 7 N. 3 R. 11 E. W
3 miles W of Huffport
(distance) (direction) (nearest town)

WELL PURPOSE:

Home

(home, irrigation, municipal, industrial)

WELL COMPLETION DATA:

- (1) diameter (inches) 2"
- (2) total depth (feet) 410 ft.
- (3) static water level (feet) 20' below above top of ground.
- (4) casing PVC, 400
(material) (depth)
 if telescope see back.
(size)
- (5) screen 10', 400
(length) (depth to top)
2", PVC
(size) (material)
- (6) pump _____ (HP) _____ (yield gpm)
(type power)
- (7) electric log _____ (yes or no)

CODED

(organization running log)

(8) how well bottom plugged Sand
Shark

DRILLERS REMARKS:

Owner install his own pump


DEPT. OF NATURAL RESOURCES
BUREAU OF LAND & WATER RESOURCES

MAR 18 1981

RECEIVED

If well telescopes please sketch and show depths.

GROUND LEVEL

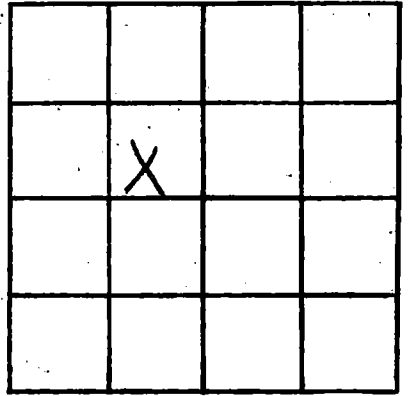

SECTION 13

Please indicate well location X.

ADDITIONAL INFORMATION

If more than one screen, show locations of each on sketch.