

HARRISON  
L 573  
3-14-81  
3-14-81 19  
 date well completed

MISSISSIPPI  
 BOARD OF WATER COMMISSIONERS  
 416 North State Street  
 Jackson, Mississippi 39201

**CODED**

**WATER WELL DRILLERS LOG**  
**BRADEN PUMP AND WELL SERVICE, INC.**  
 firm name HARRISON  
 county well located

LANDOWNER:  
Mathew Matette  
4900 Kendall Ave  
Gulfport, MS  
 (mailing address)

WELL LOCATION:  
 sec. 36 7 N R 11 E  
 (S) (W)  
 miles 1.1 of Gulfport  
 (distance) (direction) (nearest town)

WELL PURPOSE: water for house  
 (home, irrigation, municipal, industrial)

WELL COMPLETION DATA:

(1) diameter (inches) 4 x 2

(2) total depth (feet) 700'

(3) static water level (feet) 40 below top of ground.

(4) casing PVC total (material), (depth) total

4 x 2 (size) if telescope see back.

(5) screen 10' (length), 680 (depth to top)

2" (size), PVC (material)

(6) pump 1 1/2 sub 25 (HP) (yield gpm)


230 (type power)

(7) electric log NO (yes or no)

(organization running log)

(8) how well bottom plugged: 2" sand shark

description of formations encountered	from	to
SAND	0	35
CLAY	35	40
SAND	40	70
CLAY	70	75
SAND	75	90
CLAY	90	100
SAND	100	120
CLAY	120	150
SAND	150	180
CLAY	180	210
SAND	210	220
CLAY	220	230
SAND	230	240
CLAY	240	250
SAND	250	260
CLAY	260	270
SAND	270	280
CLAY	280	290
SAND	290	300
CLAY	300	310
SAND	310	320
CLAY	320	330
SAND	330	340
CLAY	340	350
SAND	350	360
CLAY	360	370
SAND	370	380
CLAY	380	390
SAND	390	400
CLAY	400	410
SAND	410	420
CLAY	420	430
SAND	430	440
CLAY	440	450
SAND	450	460
CLAY	460	470
SAND	470	480
CLAY	480	490
SAND	490	500
CLAY	500	510
SAND	510	520
CLAY	520	530
SAND	530	540
CLAY	540	550
SAND	550	560
CLAY	560	570
SAND	570	580
CLAY	580	590
SAND	590	600
CLAY	600	610
SAND	610	620
CLAY	620	630
SAND	630	640
CLAY	640	650
SAND	650	660
CLAY	660	670
SAND	670	680
CLAY	680	690
SAND	690	700

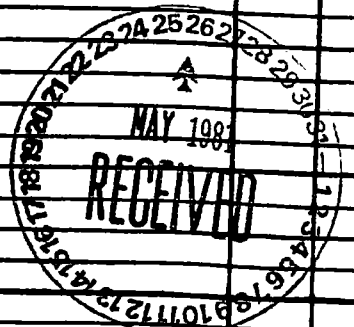

DRILLERS REMARKS:  
10' tail pipe

If well telescopes please sketch and show depths.

**GROUND LEVEL**

24" SCH 40  
 PVC  
 28" SCH 40  
 PVC  
 24" SCH 40  
 PVC  
 22" SCH 40  
 PVC  
 20" SCH 40  
 PVC  
 18" SCH 40  
 PVC  
 16" SCH 40  
 PVC  
 14" SCH 40  
 PVC  
 12" SCH 40  
 PVC  
 10" SCH 40  
 PVC  
 8" SCH 40  
 PVC  
 6" SCH 40  
 PVC  
 4" SCH 40  
 PVC  
 2" SCH 40  
 PVC  
 SAND  
 SHARK

2000  
 680  
 690  
 700

		X	

SECTION 36

Please indicate well location X.

**ADDITIONAL INFORMATION**

If more than one screen, show locations of each on sketch.

