

MISSISSIPPI DEPARTMENT OF NATURAL RESOURCES

Bureau of Land and Water Resources

Southport Mall

P.O. Box 10631

Jackson, Mississippi 39209

WATER WELL DRILLERS LOG

CODED

HARRISON
L 574
4/14/81
4/14/81

date well completed

firm name

county well located

Lyman Well Co.

Harrison

LANDOWNER: Virgil Anderson
Rt 11
Gulfport, Md 39501
(mailing address)

Description of formations encountered

from

to

WELL LOCATION:
sec. 5 T-7 N R-11 E
8 miles (distance) S of Gulfport (nearest town)

Sand & Red Clay mixed yellow sand 0 30
30 110

Gray Clay 110 210

Blue Clay 210 440

Sand 440 520

Blue Clay 520 580

Sand 580 680

WELL PURPOSE: Home
(Home, Irrigation, municipal, Industrial)

WELL COMPLETION DATA:

- (1) diameter (inches) 2"
- (2) total depth (feet) 680'
- (3) static water level (feet) 74' below top of ground

- (4) casing PVC 670' (material), (depth)
2" (size) if telescope see back.


- (5) screen 10' 670' (length), (depth to top)
2" (size), PVC (material)

- (6) pump 1 (HP), 8 (yield gpm)
electric (type power)

- (7) electric log No (yes or no)
No (organization running log)

- (8) how well bottom plugged sand shark

CODED

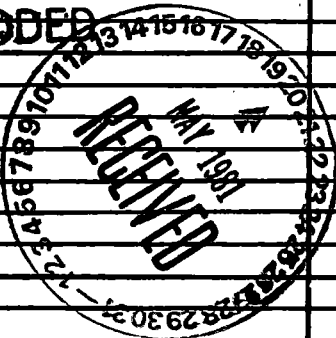

DEPT. OF NATURAL RESOURCES
BUREAU OF LAND & WATER RESOURCES

MAY 20 1981

RECEIVED

DRILLERS REMARKS:

If well telescopes please sketch and show depths.

GROUND LEVEL

SECTION _____

Please indicate well location X.

ADDITIONAL INFORMATION

If more than one screen, show locations of each on sketch.