

Harrison
L 575
5-19-81

MISSISSIPPI
BOARD OF WATER COMMISSIONERS
416 North State Street
Jackson, Mississippi 39201

CODED

WATER WELL DRILLING LOG

BRADEN PUMP AND WELL SERVICE, INC.

HARRISON

5-19-81
date well completed

firm name

county well located

LANDOWNER:
JAMES ROSS
Rt. 11, Box 388

description of formations encountered

from to

Gulfport, MS
(mailing address)

Clay	0	15
Sand	15	30
Clay	30	40
Sand	40	50
Clay	50	150
Sand	150	200

WELL LOCATION:

sec. 7 T 7 N R. 11 E
2 1/2 miles NW of Landon
(distance) (direction) (nearest town)

CODED

WELL PURPOSE: home
(home, irrigation, municipal, industrial)

WELL COMPLETION DATA:

- (1) diameter (inches) 2"
- (2) total depth (feet) 200'
- (3) static water level (feet) 30 below top of ground
- (4) casing PVC, total (material), (depth)
2" (size) If telescope see back.
- (5) screen 10' (length), 180' (depth to top)
2" (size), PVC underbar (material)
- (6) pump 1 (HP), 12 (yield gpm)
110 (type power)
- (7) electric log NO (yes or no)



(organization running log)


(8) how well bottom plugged
2" SAND SHARK

DRILLERS REMARKS:

10' tail pipe

If well telescopes please sketch and show depths.

GROUND LEVEL

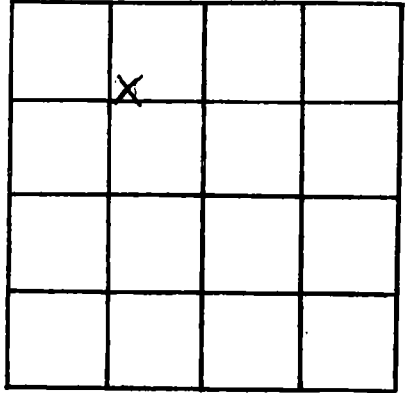

SECTION 7

Please indicate well location X.

ADDITIONAL INFORMATION

Lined area for additional information.

If more than one screen, show locations of each on sketch.

