

MISSISSIPPI DEPARTMENT OF NATURAL RESOURCES

Bureau of Land and Water Resources

Southport Mall

P.O. Box 10631

CODED

Jackson, Mississippi 39209

WATER WELL DRILLERS LOG

HARRISON
L 576
4/22/81
4/22/81

date well completed

firm name

county well located

Lyman Well Co.

Harrison

LANDOWNER:

Bulford Farmer

Rt 11 Box 237

Southport 39503
(mailing address)

description of formations encountered

from

to

<u>Redd yellow Clay</u>	<u>0</u>	<u>21</u>
<u>Red W yellow sand</u>	<u>31</u>	<u>128</u>
<u>gray Clay</u>	<u>128</u>	<u>244</u>
<u>fine Sand</u>	<u>244</u>	<u>289</u>
<u>fair Sand</u>	<u>284</u>	<u>350</u>
<u>Blue Clay</u>	<u>350</u>	<u>450</u>
<u>Sand</u>	<u>450</u>	<u>537</u>

WELL LOCATION:

sec. 5 T. 16 N. R. 11 E
7 miles (distance) W (direction) of Southport (nearest town)


WELL PURPOSE:

(home, irrigation, municipal, industrial)

WELL COMPLETION DATA:

- (1) diameter (inches) 2"
- (2) total depth (feet) 537'
- (3) static water level (feet) 64 below top of ground.
- (4) casing PVC 527'
(material) (depth)
2" (size) If telescope see back.
- (5) screen 10' 527'
(length) (depth to top)
2" (size) PVC (material)
- (6) pump 1 10
(HP) (yield gpm)
Electric (type power)
- (7) electric log No
(yes or no)
No
(organization running log)
- (8) how well bottom plugged sand
shark

CODED

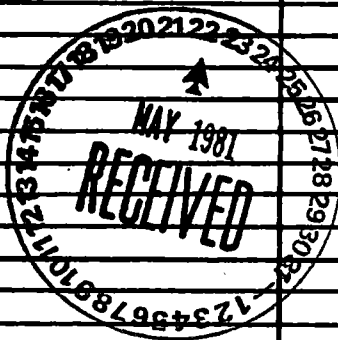

DRILLERS REMARKS:

