

MISSISSIPPI DEPARTMENT OF NATURAL RESOURCES

Bureau of Land and Water Resources

Southport Mall

P.O. Box 10631

CODED

Jackson, Mississippi 39209

WATER WELL DRILLERS LOG

HARRISON
L 578

3/25/81
March 25, 1981

Newcom Well Drilling Harrison

date well completed

firm name

county well located

LANDOWNER: J. H. Moody
2303 Robert Dr.
Gulfport Ms.
(mailing address)

description of formations encountered

from

to

Clay	0	18
Sand	18	35
White Clay	35	120
Blue Clay	120	300
Green Sand	300	315
Blue Clay	315	398
Green Sand	398	450
COARSE SAND	450	475

WELL LOCATION:

sec 2 T 7 N R 11 E
5 miles E of Gulfport
(distance) (direction) (nearest town)

WELL PURPOSE: Home
(home, irrigation, municipal, industrial)

WELL COMPLETION DATA:

- (1) diameter (inches) 2"
- (2) total depth (feet) 475
- (3) static water level (feet) 38' below top of ground
- (4) casing PVC 465' (material) (depth)
- (5) screen 10' 465' (length) (depth to top)
2" (size) PVC (material)
- (6) pump 1/2 (HP) 12 (yield gpm)
electric (type power)
- (7) electric log (yes or no)

CODED

DEPT. OF NATURAL RESOURCES
BUREAU OF LAND & WATER RESOURCES


MAY 18 1981

RECEIVED

DRILLERS REMARKS:

If well telescopes please sketch and show depths.

GROUND LEVEL

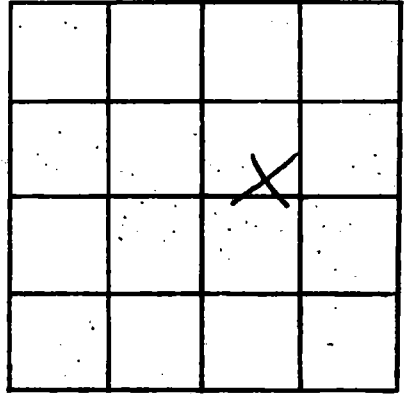

SECTION 2

Please indicate well location X.

ADDITIONAL INFORMATION

If more than one screen,
show locations of each on sketch.