

MISSISSIPPI DEPARTMENT OF NATURAL RESOURCES
 Bureau of Land and Water Resources
 Southport Mall
 P.O. Box 10631
 Jackson, Mississippi 39209
WATER WELL DRILLERS LOG

CODED

HARRISON
L 581
8-15-81

8-15-81 19 BRADEN PUMP AND WELL SERVICE, INC. HARRISON
 date well completed ROUTE 1, BOX 480 county well located

LANDOWNER:
OSCAR O'NEIL
22 Greenbriar DR
Gulfport, MS 39501
 (mailing address)


WELL LOCATION:
 sec 25 T 7 N R 11 E
 (S) (W)
17 miles Gulfport
 (distance) (direction) (nearest town)

WELL PURPOSE: home
 (home, irrigation, municipal, industrial)

- WELL COMPLETION DATA:
- diameter (inches) 2"
 - total depth (feet) 360
 - static water level (feet) 2 below above top of ground.
 - casing PVC, total
 (material) (depth)
2" If telescope see back.
 (size)
 - screen 10', 340'
 (length) (depth to top)
2", PVC underbar
 (size) (material)
 - pump 1 8
 (HP) (yield gpm)
230
 (type power)
 - electric log NO
 (yes or no)
 (organization running log)
 - how well bottom plugged
2' SAND SHARK

description of formations encountered	from	to
CLAY	0	20
SAND	20	40
CLAY	40	50
SAND	50	60
GRAVEL	60	70
SAND + GRAVEL	70	80
SAND	80	130
CLAY	130	135
SAND	135	140
CLAY	140	155
SAND	155	160
CLAY	160	175
SAND	175	270
CLAY	270	320
SAND	230	360

CODED

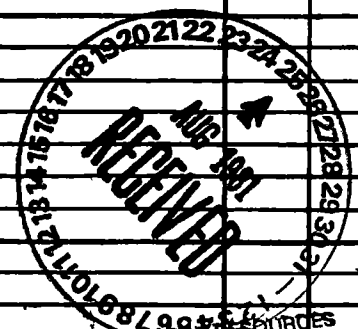

DEPT. OF NATURAL RESOURCES
 BUREAU OF LAND & WATER RESOURCES

AUG 25 1981

RECEIVED

DRILLERS REMARKS:
10' tail pipe

