

MISSISSIPPI DEPARTMENT OF NATURAL RESOURCES

Bureau of Land and Water Resources

Southport Mall

P.O. Box 10631

CODED

Jackson, Mississippi 39209

WATER WELL DRILLERS LOG

HARRISON
L 583
10-13-81

Oct. 13 1981
date well completed

Duncan Well Drilling
firm name

Harrison
county well located

LANDOWNER: W. J. Cuevas

description of formations encountered

from to

Rt. 1 Box 1606
Gpt. Ms.
(mailing address)

<u>Sand & Gravel</u>	<u>0</u>	<u>100</u>
<u>Blue clay</u>	<u>100</u>	<u>210</u>
<u>fine sand</u>	<u>210</u>	<u>315</u>
<u>Blue clay</u>	<u>315</u>	<u>360</u>
<u>fine sand</u>	<u>360</u>	<u>400</u>
<u>Coarse sand</u>	<u>400</u>	<u>441</u>

WELL LOCATION:

sec. 19 T. 7 N. R. 11 E.
3 miles S.W. of Blueport
(distance) (direction) (nearest town)

WELL PURPOSE: Home
(home, irrigation, municipal, industrial)

WELL COMPLETION DATA:

- (1) diameter (inches) 2"
- (2) total depth (feet) 441 ft.
- (3) static water level (feet) 8' below above top of ground.
- (4) casing PVC 431'
(material) (depth)
- (5) screen 10' 431'
(length) (depth to top)
- (6) pump 1 10
(HP) (yield gpm)
- (type power) electric
- (7) electric log (yes or no) _____

CODED

(organization running log)

(8) how well bottom plugged Sand
Shark


DRILLERS REMARKS:

DEPT. OF NATURAL RESOURCES
BUREAU OF LAND & WATER RESOURCES

OCT 19 1981
RECEIVED

If well telescopes please sketch and show depths.

GROUND LEVEL

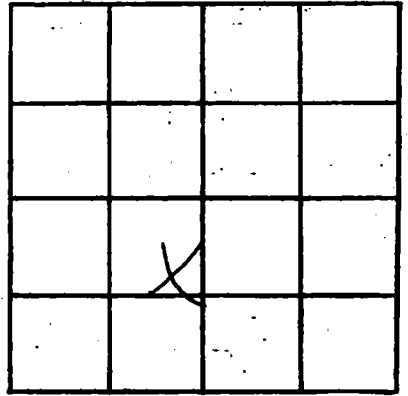

SECTION 19

Please indicate well location X.

ADDITIONAL INFORMATION

If more than one screen,
show locations of each on sketch.