

MISSISSIPPI DEPARTMENT OF NATURAL RESOURCES

Bureau of Land and Water Resources

Southport Mall

P.O. Box 10631

Jackson, Mississippi 39209

WATER WELL DRILLERS LOG

CODED

HARRISON
L 584
10/23/81

10/23/81 19 Syman Well Harrison
date well completed firm name county well located

LANDOWNER: James Clark
Rt. 11, Box 61
Gulfport, Md 39503
(mailing address)

description of formations encountered	from	to
Red Clay Sand	0	60
Gravel	60	180
Gray Clay fine sand	180	240
fine & fair sand	180	240

WELL LOCATION:
sec. 8 T. 7 N. R. 11 E.
2 miles S/W of Orange cross
(distance) (direction) (nearest town)

WELL PURPOSE: home
(home, irrigation, municipal, industrial)

- WELL COMPLETION DATA:
- (1) diameter (inches) 2
 - (2) total depth (feet) 240
 - (3) static water level (feet) 50 below above top of ground.
 - (4) casing PVC, 230,
(material) (depth)
2 if telescope see back.
(size)
 - (5) screen 10, 230
(length) (depth to top)
2, PVC
(size) (material)
 - (6) pump 1, 12
(HP) (yield gpm)
electric
(type power)
 - (7) electric log No
(yes or no)
NO
(organization running log)
 - (8) how well bottom plugged sand
seal

CODED


DEPT. OF NATURAL RESOURCES
BUREAU OF LAND & WATER RESOURCES

OCT 20 1991
RECEIVED

DRILLERS REMARKS:

If well telescopes please sketch and show depths.

GROUND LEVEL

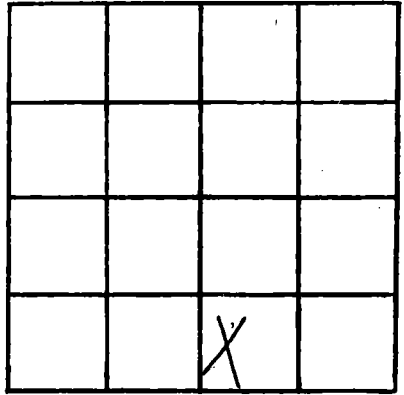

SECTION 8

Please indicate well location X.

ADDITIONAL INFORMATION

If more than one screen,
show locations of each on sketch.