

MISSISSIPPI DEPARTMENT OF NATURAL RESOURCES

Bureau of Land and Water Resources

Southport Mall

P.O. Box 10631

CODED

Jackson, Mississippi 39209

WATER WELL DRILLERS LOG
COASTAL DRILLING & SERVICE CO.

ROUTE 1 BOX 618

firm name

BILOXI, MISS. 39532

county well located

L 592 7th III

12/17/81 19

Harrison

LANDOWNER

Dean Zellebach

description of formations encountered

from

to

Cresate lood

top soil

1 2

4pt. miss (mailing address)

red clay
white clay
brown white sand

2 5
5 18
18 30'-4"

WELL LOCATION:

sec 22 T 2 N R 11 E S 5 W
Turkey Creek
(distance) miles (direction) of (nearest town)

WELL PURPOSE:
(home, irrigation, municipal, industrial)

WELL COMPLETION DATA:

- (1) diameter (inches) 2"
- (2) total depth (feet) 30'-4"
- (3) static water level (feet) 7'-3" below top of ground.
- (4) casing (material) (depth) 25'-4"
- (size) If telescope see back.
- (5) screen (length) (depth to top) 5' 25'-4"
- (size) (material) 2" pc
- (6) pump (HP) (yield gpm) 1/2 hp
- (type power) ele
- (7) electric log (yes or no) no

CODED

(organization running log)

(8) how well bottom plugged

2" back wash valve
DRILLERS REMARKS
good sand
well sure pump good


DEPT OF NATURAL RESOURCES
BUREAU OF LAND & WATER RESOURCES

JAN 15 1982

RECEIVED

If well telescopes please sketch and show depths.

GROUND LEVEL

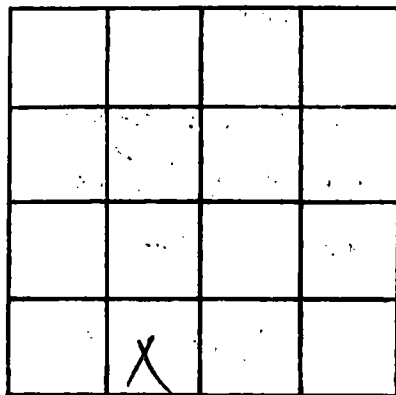

SECTION _____

Please indicate well location X.

ADDITIONAL INFORMATION

If more than one screen, show locations of each on sketch.