

MISSISSIPPI DEPARTMENT OF NATURAL RESOURCES

Bureau of Land and Water Resources

Southport Mall

P.O. Box 10631

CODED

Jackson, Mississippi 39209

WATER WELL DRILLERS LOG

COASTAL DRILLING & SERVICE CO.

ROUTE 1 BOX 618

firm name

BILOXI, MISS. 39532

county well located

12/17/81

date well completed

19

Harrison

HARRISON
L 593

LANDOWNER: James Zellerbach

Creosote Road

dpt min
(mailing address)

description of formations encountered

from

to

| | | |
|------------------------|-----------|--------------|
| <u>top soil</u> | <u>1</u> | <u>2</u> |
| <u>red clay</u> | <u>2</u> | <u>10</u> |
| <u>light blue clay</u> | <u>10</u> | <u>25</u> |
| <u>fine sand</u> | <u>25</u> | <u>31'2"</u> |

WELL LOCATION:

sec 22 T 7 N R 11 S W
Turkey Creek
(distance) (direction) or (nearest town)

WELL PURPOSE: Monitoring
(home, irrigation, municipal, industrial)

WELL COMPLETION DATA:

- (1) diameter (inches) 2"
- (2) total depth (feet) 31'2"
- (3) static water level (feet) 9'6" below top of ground.
- (4) casing PC, 26'2"
(material) (depth)
- (size) If telescope see back.
- (5) screen 5', 26'2"
(length) (depth to top)
- (size) 2" (material) PC
- (6) pump 1/2 500
(HP) (yield gpm)
- (type power) Ele
- (7) electric log no
(yes or no)
- (organization running log) no

CODED

DEPT. OF NATURAL RESOURCES
BUREAU OF LAND & WATER RESOURCES

JAN 15 1982


RECEIVED

(8) how well bottom plugged

2" medium gravel
DRILLERS REMARKS: 19-B
from top soil sand

If well telescopes please sketch and show depths.

GROUND LEVEL

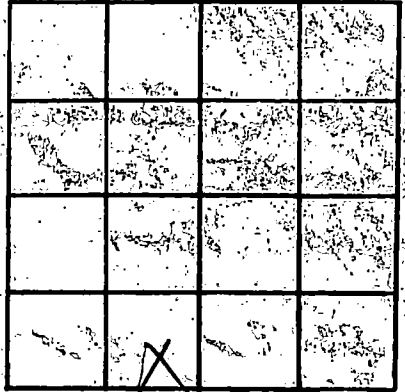

SECTION _____

Please indicate well location X.

ADDITIONAL INFORMATION

If more than one screen, show locations of each on sketch.