

MISSISSIPPI DEPARTMENT OF NATURAL RESOURCES

Bureau of Land and Water Resources

Southport Mall

P.O. Box 10631

Jackson, Mississippi 39209

CODED

WATER WELL DRILLERS LOG

Harrison  
L 595

Nov. 19 1981  
date well completed

Duncan Well Drilling  
firm name

Harrison  
county well located

LANDOWNER: Edward Deloach  
Pt. 1 Box 237  
Hulport, Mo. 39503  
(mailing address)

WELL LOCATION:  
sec. 7 T 7 N R 11 E  
6 miles N of Long Beach  
(distance) (direction) (nearest town)

WELL PURPOSE: Home  
(home, irrigation, municipal, industrial)

WELL COMPLETION DATA:  
(1) diameter (inches) 2"  
(2) total depth (feet) 525'  
(3) static water level (feet) 38' below above top of ground.  
(4) casing PVC, 51.5' (material) (depth)  
(size) If telescope see back.  
(5) screen 10' 51.5' (length) (depth to top)  
(size) PVC (material)  
(6) pump 1 12 (HP) (yield gpm)  
electric (type power)  
(7) electric log (yes or no)  
(organization running log)  
(8) how well bottom plugged Sand  
Muck

description of formations encountered	from	to
clay	0	18
Sands	18	45
Blue Clay	45	80
Sand	80	90
Clay	90	100
Sands	100	110
Blue Clay	110	326
Sands	326	340
Blue Clay	340	390
Sand	390	425
Blue Clay	425	457
Line Sand	457	490
Coarse Sand	490	525

CODED

DEPT. OF NATURAL RESOURCES  
BUREAU OF LAND & WATER RESOURCES


FEB 11 1982

RECEIVED

DRILLERS REMARKS:

If well telescopes please sketch and show depths.

GROUND LEVEL

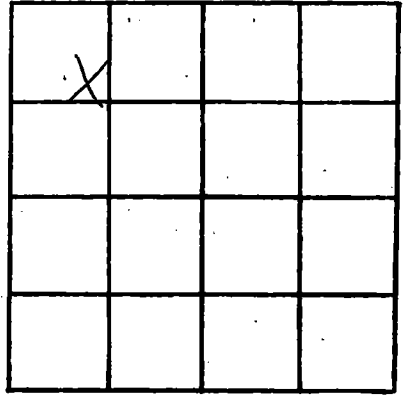

SECTION 7

Please indicate well location X.

ADDITIONAL INFORMATION

If more than one screen, show locations of each on sketch.