

MISSISSIPPI DEPARTMENT OF NATURAL RESOURCES

Bureau of Land and Water Resources

Southport Mall

P.O. Box 10631

Jackson, Mississippi 39209

WATER WELL DRILLERS LOG

CODED

Harrison  
L 597

Dec 4 1981  
date well completed

Duncan Well Drilling Harrison  
firm name county well located

LANDOWNER: J. R. Gore  
Rt. 2 Box 106  
Southport, Ms. 39508  
(mailing address)

WELL LOCATION:  
sec. 7 T 7 N R 11 E  
6 miles N of Southport  
(distance) (direction) (nearest town)

WELL PURPOSE: Home  
(home, irrigation, municipal, industrial)

WELL COMPLETION DATA:  
(1) diameter (inches) 2"  
(2) total depth (feet) 568 ft  
(3) static water level (feet) 32 below above top of ground.  
(4) casing PVC, 558  
(material) (depth)  
2" If telescope see back.  
(size)  
(5) screen 10', 558  
(length) (depth to top)  
2", PVC  
(size) (material)  
(6) pump 1, 10  
(HP) (yield gpm)  
electric  
(type power)  
(7) electric log —  
(yes or no)  
(organization running log)  
(8) how well bottom plugged Sand  
Shut

description of formations encountered	from	to
Clay	0	25
Sand	25	90
Clay	90	250
fine Sand	250	300
Blue Clay	300	350
Red & Blue Clay	350	390
fine Sand	390	425
Blue Clay	425	530
Course Sand	530	568

CODED

DEPT. OF NATURAL RESOURCES  
BUREAU OF LAND & WATER RESOURCES


FEB 11 1982

RECEIVE

DRILLERS REMARKS:

If well telescopes please sketch and show depths.

GROUND LEVEL

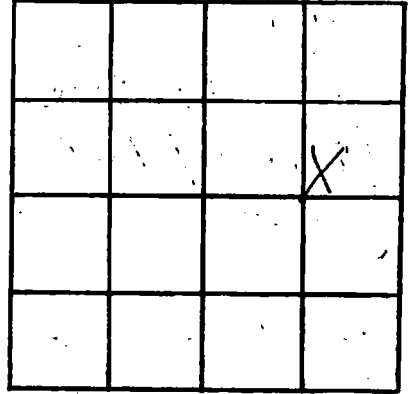

SECTION 7

Please indicate well location X.

ADDITIONAL INFORMATION

If more than one screen, show locations of each on sketch.