

Hanson
L 601

MISSISSIPPI DEPARTMENT OF NATURAL RESOURCES
Bureau of Land and Water Resources
Southport Mall
P.O. Box 10631
Jackson, Mississippi 39209
CODED
WATER WELL DRILLERS LOG

Feb. 5 1982 Duncan Well Drilling Harrison
date well completed firm name county well located

LANDOWNER: Ray Bell
Rt. 1 Box 1553
Support No. 39521
(mailing address)

description of formations encountered	from	to
<u>Sand</u>	<u>0</u>	<u>20</u>
<u>Red clay</u>	<u>20</u>	<u>60</u>
<u>fine sand</u>	<u>60</u>	<u>70</u>
<u>Blue clay</u>	<u>70</u>	<u>80</u>
<u>Course sand</u>	<u>80</u>	<u>100</u>

WELL LOCATION:
sec 19 T 7 N R 11 E
3 miles SW of Support
(distance) (direction) (nearest town)

WELL PURPOSE: Home
(home, irrigation, municipal, industrial)

WELL COMPLETION DATA:

- (1) diameter (inches) 2"
- (2) total depth (feet) 100'
- (3) static water level (feet) 8' below above top of ground.
- (4) casing PVC 90'
(material) (depth)
 If telescope see back.
(size)
- (5) screen 10' 90'
(length) (depth to top)
2" PVC
(size) (material)
- (6) pump 1/2 6
(HP) (yield gpm)
electric
(type power)
- (7) electric log
(yes or no)

(organization running log)
- (8) how well bottom plugged Sand
Shark

CODED

DEPT. OF NATURAL RESOURCES
BUREAU OF LAND & WATER RESOURCES


AUG 30 1982

RECEIVED

DRILLERS REMARKS:

If well telescopes please sketch and show depths.

GROUND LEVEL

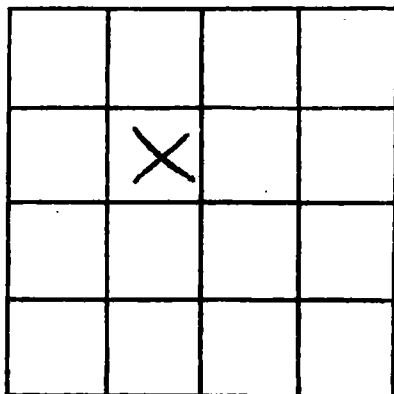

SECTION 19

Please indicate well location X.

ADDITIONAL INFORMATION

If more than one screen, show locations of each on sketch.