

**MISSISSIPPI DEPARTMENT OF NATURAL RESOURCES**  
**Bureau of Land and Water Resources**  
 Southport Mall  
 P.O. Box 10631  
 Jackson, Mississippi 39209  
**WATER WELL DRILLERS LOG**

**CODED**

Harrison  
L 602

Feb. 5 1982 Duncan Well Drilling Harrison  
 date well completed firm name county well located

LANDOWNER: Richard Gural  
Rt. 1 Box 1604  
Sulphur, Mo. 39501  
 (mailing address)

description of formations encountered	from	to
<u>Sand</u>	<u>0</u>	<u>20</u>
<u>Red Clay</u>	<u>20</u>	<u>60</u>
<u>Fine Sand</u>	<u>60</u>	<u>70</u>
<u>Blue Clay</u>	<u>70</u>	<u>80</u>
<u>Coarse Sand</u>	<u>80</u>	<u>100</u>

WELL LOCATION:  
 sec. 19 T 7 N R 11 E  
3 miles SW of Sulphur  
 (distance) (direction) (nearest town)

WELL PURPOSE: Home  
 (home, irrigation, municipal, industrial)

WELL COMPLETION DATA:

(1) diameter (inches) 2"

(2) total depth (feet) 100'

(3) static water level (feet) 8' below above top of ground.

(4) casing PVC 90'  
 (material) (depth)  
 (size) if telescope see back.

(5) screen 10' 90'  
 (length) (depth to top)  
2" PVC  
 (size) (material)

(6) pump \_\_\_\_\_ (HP) \_\_\_\_\_ (yield gpm)  
electric  
 (type power)

(7) electric log \_\_\_\_\_ (yes or no)  
 (organization running log)

(8) how well bottom plugged Sand  
Shark

**CODED**

DEPT. OF NATURAL RESOURCES  
 BUREAU OF LAND & WATER RESOURCES


**AUG 30 1982**

**RECEIVED**

DRILLERS REMARKS:  
Owner installed  
two down pumps

If well telescopes please sketch and show depths.

GROUND LEVEL

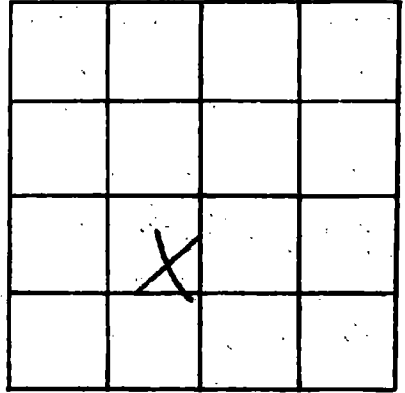

SECTION 19

Please indicate well location X.

ADDITIONAL INFORMATION

If more than one screen, show locations of each on sketch.