

**MISSISSIPPI DEPARTMENT OF NATURAL RESOURCES**  
**Bureau of Land and Water Resources**  
 Southport Mall  
 P.O. Box 10631  
 Jackson, Mississippi 39209  
**WATER WELL DRILLERS LOG**

**CODED**

Harrison  
L 603

Aug. 11 1982 Duncan Well Drilling Harrison  
 date well completed firm name county well located

**LANDOWNER:** Nathan Smith  
Rt. 1 Box 201  
Southport Ms.  
 (mailing address)

**WELL LOCATION:**  
 sec. 7 T 7 N R 11 E  
6 miles N of Long Beach  
 (distance) (direction) (nearest town)

**WELL PURPOSE:** None  
 (home, irrigation, municipal, industrial)

**WELL COMPLETION DATA:**

(1) diameter (inches) 2"

(2) total depth (feet) 410 ft.

(3) static water level (feet) 30' below above top of ground.

(4) casing PVC, 400'  
 (material) (depth)  
 (size) if telescope see back.

(5) screen 10', 400'  
 (length) (depth to top)  
2", PVC  
 (size) (material)

(6) pump 1 12  
 (HP) (yield gpm)  
electric  
 (type power)

(7) electric log                       
 (yes or no)  
                      
 (organization running log)

(8) how well bottom plugged Sand  
Shank

description of formations encountered	from	to
clay	0	18
sand	18	45
Blue clay	45	80
sand	80	90
clay	90	100
sand	100	110
Blue clay	110	326
sand	326	340
Blue clay	340	360
Coarse Sand	360	410

**CODED**

DEPT. OF NATURAL RESOURCES  
 BUREAU OF LAND & WATER RESOURCES


APR 30 1982

**RECEIVED**

**DRILLERS REMARKS:**

If well telescopes please sketch and show depths.

GROUND LEVEL

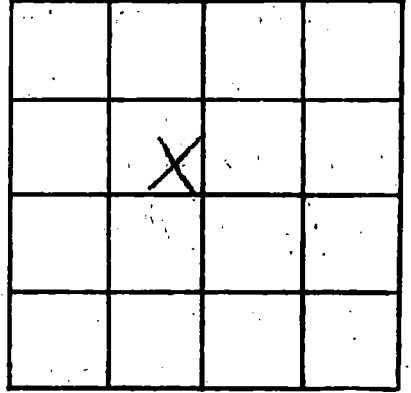

SECTION 7

Please indicate well location X.

ADDITIONAL INFORMATION

If more than one screen, show locations of each on sketch.