

MISSISSIPPI DEPARTMENT OF NATURAL RESOURCES

Bureau of Land and Water Resources

Southport Mall

P.O. Box 10631

Jackson, Mississippi 39209

CODED

COASTAL DRILLING & WELL DRILLERS LOG

ROUTE 1 BOX 618

Harrison
L 605

5/7/82
date well completed

19 BILOXI, MISS. name

Harrison
county well located

LANDOWNER: John Oden
Rt 2 Box 240
Apt hrs
(mailing address)

description of formations encountered	from	to
<u>Top Soil</u>	<u>1</u>	<u>3</u>
<u>Red Clay</u>	<u>3</u>	<u>35</u>
<u>Super Sand</u>	<u>35</u>	<u>60</u>
<u>Soft Blue Clay</u>	<u>60</u>	<u>190</u>
<u>fine water sand</u>	<u>190</u>	<u>210</u>
<u>Good water sand</u>	<u>210</u>	<u>245</u>

WELL LOCATION:
sec. 18 T 7 N R 11 E
New Hope
(distance) (direction) (nearest town)

WELL PURPOSE: home
(home, irrigation, municipal, industrial)

WELL COMPLETION DATA:

(1) diameter (inches) 2"

(2) total depth (feet) 245'

(3) static water level (feet) 20' ^{below} above top of ground.

(4) casing PC 235'
(material) (depth)

(size) if telescope see back.

(5) screen 10' 235'
(length) (depth to top)

2" PC
(size) (material)

(6) pump None 13
(HP) (yield gpm)

5hp
(type power)

(7) electric log no
(yes or no)

(organization running log)

CODED

(8) how well bottom plugged 2" beach with gravel
DRILLERS REMARKS: 198


DEPT. OF NATURAL RESOURCES
BUREAU OF LAND & WATER RESOURCES

DEC - 1 1982

RECEIVED

If well telescopes please sketch and show depths.

GROUND LEVEL

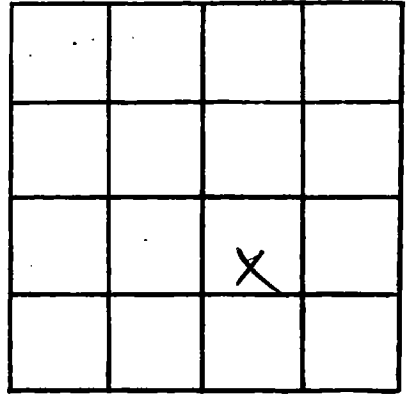

SECTION _____

Please indicate well location X.

ADDITIONAL INFORMATION

If more than one screen,
show locations of each on sketch.