

MISSISSIPPI DEPARTMENT OF NATURAL RESOURCES

Bureau of Land and Water Resources

Southport Mall

P.O. Box 10631

Jackson, Mississippi 39209

CODED

Harrison
L 606

COASTAL DRILLING & SERVICE CO.

ROUTE 1 BOX 618

BILOXI, MISS. 39532

Harrison

8/22/72
date well completed

firm name

county well located

LANDOWNER: Kenneth Buck
Canal Road
Spt. MS
(mailing address)

description of formations encountered

from

to

<u>top soil</u>	<u>1</u>	<u>5</u>
<u>Red Clay</u>	<u>5</u>	<u>18</u>
<u>pipe clay</u>	<u>18</u>	<u>30</u>
<u>Coarse white sand</u>	<u>30</u>	<u>60</u>
<u>Soft Blue Clay</u>	<u>60</u>	<u>175</u>
<u>white sand. Ribs</u>	<u>175</u>	<u>210</u>
<u>Soft Blue Clay</u>	<u>210</u>	<u>340</u>
<u>hard blue clay</u>	<u>340</u>	<u>520</u>
<u>fine white sand</u>	<u>520</u>	<u>550</u>
<u>grd white sand</u>	<u>550</u>	<u>590</u>

WELL LOCATION:

sec. 6 T. 7 R. 11 E
2 1/2 mi north New Hope
(distance) (direction) (nearest town)

WELL PURPOSE:

(home, irrigation, municipal, industrial) home

WELL COMPLETION DATA:

- (1) diameter (inches) 2"
- (2) total depth (feet) 590'
- (3) static water level (feet) 60' below top of ground.
- (4) casing PC (material), 580' (depth)
(size) if telescope see back.
- (5) screen 10' (length), 580' (depth to top)
2" (size), PC (material)
- (6) pump 1/2 HP (HP), 10 (yield gpm)
GL (type power)
- (7) electric log no (yes or no)

CODED


(organization running log)
2" bedrock valve
(8) how well bottom plugged 19-6

DRILLERS REMARKS:

DEPT. OF NATURAL RESOURCES
BUREAU OF LAND & WATER RESOURCES
RECEIVED
DEC - 1 1982

If well telescopes please sketch and show depths.

GROUND LEVEL

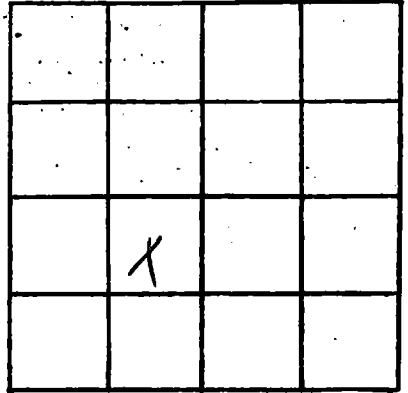

SECTION _____

Please indicate well location X.

ADDITIONAL INFORMATION

If more than one screen,
show locations of each on sketch.