

MISSISSIPPI DEPARTMENT OF NATURAL RESOURCES

Bureau of Land and Water Resources

Southport Mall

P.O. Box 10631

Jackson, Mississippi 39209

CODED

COASTAL DRILLING & SERVICE CO.

ROUTE 1 BOX 618

BILOXI, MISS 39532

county well located

Harrison
L607

8/30/82
date well completed

John Key Corner
LANDOWNER:

Deleard Loach
Sgt. Ms
(mailing address)

WELL LOCATION:
sec 11 T 7 N R 11 E
(None North I 10)
(distance) (direction) (nearest town)

WELL PURPOSE: home
(home, irrigation, municipal, industrial)

WELL COMPLETION DATA:

(1) diameter (inches) 2"

(2) total depth (feet) 735

(3) static water level (feet) 40' below top of ground

(4) casing pit 720'
(material) (depth)

(size) if telescope see back.

(5) screen 15' 720'
(length) (depth to top)

2"
(size) pit
(material)

(6) pump None 12
(HP) (yield gpm)

ell
(type power)

(7) electric log no
(yes or no)

(organization running log)

description of formations encountered	from	to
<u>top soil</u>	<u>1</u>	<u>3</u>
<u>Red Clay</u>	<u>3</u>	<u>15</u>
<u>white sand</u>	<u>15</u>	<u>45</u>
<u>soft blue clay</u>	<u>45</u>	<u>210</u>
<u>fine water sand</u>	<u>210</u>	<u>240</u>
<u>soft blue clay</u>	<u>240</u>	<u>310</u>
<u>fine water sand</u>	<u>310</u>	<u>530</u>
<u>hard blue clay</u>	<u>530</u>	<u>680</u>
<u>course water sand</u>	<u>680</u>	<u>735</u>


CODED

(8) how well bottom plugged
2 feet water table
DRILLERS REMARKS: 19-13

DEPT. OF NATURAL RESOURCES
BUREAU OF LAND & WATER RESOURCES
RECEIVED
DEC-1 1982

If well telescopes please sketch and show depths.

GROUND LEVEL

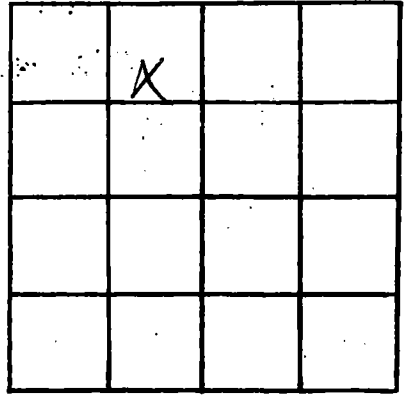

SECTION _____

Please indicate well location X.

ADDITIONAL INFORMATION

A series of horizontal lines for writing additional information, located below the 'ADDITIONAL INFORMATION' header.

If more than one screen, show locations of each on sketch.