

MISSISSIPPI DEPARTMENT OF NATURAL RESOURCES

Bureau of Land and Water Resources

Southport Mall

P.O. Box 10631

Jackson, Mississippi 39209

COASTAL DRILLING & SERVICE CO. WATER WELL DRILLERS LOG

CODED

ROUTE 1 BOX 618

Harrison  
L609

8/25/82  
date well completed

19 BILOXI, MISS. 39533  
name

Harrison  
county well located

LANDOWNER: Forbes  
Rt 5  
apt ms  
(mailing address)

WELL LOCATION:  
sec. 18 T 7 N R 11 E  
S W  
New Hope  
(distance) (direction) (nearest town)

WELL PURPOSE: home  
(home, irrigation, municipal, industrial)

WELL COMPLETION DATA:

(1) diameter (inches) 2"

(2) total depth (feet) 500'

(3) static water level (feet) 25' below above top of ground.

(4) casing PVC 490'  
(material) (depth)  
(size) If telescope see back.

(5) screen 10' 490'  
(length) (depth to top)  
2" PVC  
(size) (material)

(6) pump 1/2 13  
(HP) (yield gpm)  
Electric  
(type power)

(7) electric log no  
(yes or no)  
(organization running log)

description of formations encountered	from	to
top soil	1	3
red clay	3	18
white fine clay	18	30
red clay	30	60
soft blue clay	60	230
hard blue clay	230	290
fine water sand	290	310
hard blue clay	310	440
fine water sand	440	470
hard water sand	470	500

CODED

DEPT. OF NATURAL RESOURCES  
BUREAU OF LAND & WATER RESOURCES


DEC - 1 1982  
RECEIVED

(8) how well bottom plugged  
2" lead wash tubes

DRILLERS REMARKS:

If well telescopes please sketch and show depths.

GROUND LEVEL

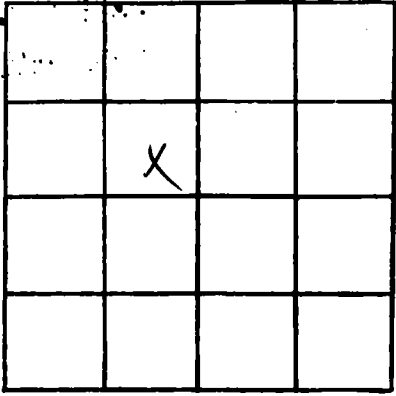

SECTION \_\_\_\_\_

Please indicate well location X.

ADDITIONAL INFORMATION

Multiple horizontal lines for writing additional information.

If more than one screen, show locations of each on sketch.