

MISSISSIPPI DEPARTMENT OF NATURAL RESOURCES

Bureau of Land and Water Resources

Southport Mall

P.O. Box 10631

Jackson, Mississippi 39209

WATER WELL DRILLERS LOG

CODED

<u>Harrison</u>
<u>L 613</u>

11/15
date well completed

1982 Hyman well Co.
firm name

Harrison
county well located

LANDOWNER: William Tucker

description of formations encountered

from

to

960 E. Beach

Red Sand

0 30

apt, Trd 39501
(mailing address)

WELL LOCATION:

sec. 3 T. 8 N. 0 R. 11 E. 0
0 miles 0 of Gulfport
(distance) (direction) (nearest town)

WELL PURPOSE: Home
(home, irrigation, municipal, industrial)

CODED

WELL COMPLETION DATA:

- (1) diameter (inches) 2"
- (2) total depth (feet) 30
- (3) static water level (feet) 25 below above top of ground.
- (4) casing PVC, 20'
(material) (depth)
2"
(size) If telescope see back.
- (5) screen 10', 30
(length) (depth to top)
2", PVC
(size) (material)
- (6) pump 1, 15
(HP) (yield gpm)
Elec.
(type power)
- (7) electric log no
(yes or no)
no
(organization running log)

(8) how well bottom plugged Sealed

DRILLERS REMARKS:


DEPT. OF NATURAL RESOURCES
BUREAU OF LAND & WATER RESOURCES

FEB 25 1983

RECEIVED

If well telescopes please sketch and show depths.

GROUND LEVEL

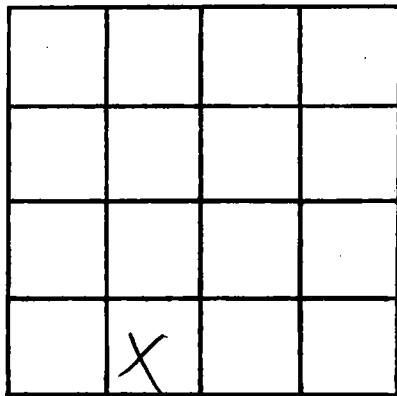

SECTION 3

Please indicate well location X.

ADDITIONAL INFORMATION

If more than one screen, show locations of each on sketch.