

Harrison
L 614

MISS

DEPARTMENT OF NATURAL RESOURCES

Bureau of Land and Water Resources

Southport Mall

P.O. Box 10631

Jackson, Mississippi 39209

WATER WELL DRILLERS LOG

CODED

12/19 1982 Stephen well Co. Harrison
 date well completed firm name county well located

LANDOWNER: A. J. Stone
Rt. 3, Box 692
Gulfport, Ms 39503
 (mailing address)

description of formations encountered	from to	
<u>Red Sand Clay</u>	<u>0</u>	<u>40</u>
<u>Blue Clay</u>	<u>40</u>	<u>70</u>
<u>medium sand</u>	<u>70</u>	<u>130</u>

WELL LOCATION:
 sec. 5 T. 7 N. R. 11 E.
7 miles N of Got.
 (distance) (direction) (nearest town)

WELL PURPOSE: Home
 (home, irrigation, municipal, industrial)

CODED

- WELL COMPLETION DATA:
- (1) diameter (inches) 2"
 - (2) total depth (feet) 130'
 - (3) static water level (feet) 10' below top of ground.
 - (4) casing PVC 100'
 (material) (depth)
2"
 (size) if telescope see back.
 - (5) screen 10' 130'
 (length) (depth to top)
2" PVC
 (size) (material)
 - (6) pump 4 25
 (HP) (yield gpm)
Glee.
 (type power)
 - (7) electric log no
 (yes or no)
no
 (organization running log)
 - (8) how well bottom plugged Sand
Shank

DEPT. OF NATURAL RESOURCES
 BUREAU OF LAND & WATER RESOURCES


FEB 25 1983

RECEIVED

DRILLERS REMARKS:

If well telescopes please sketch and show depths.

GROUND LEVEL

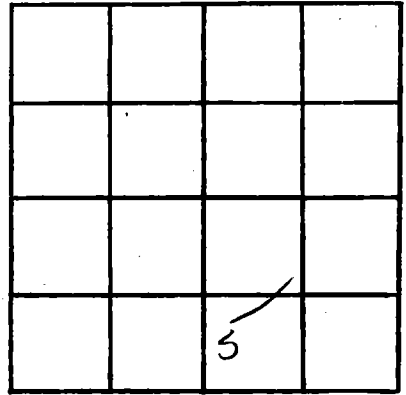

SECTION *X*

Please indicate well location X.

ADDITIONAL INFORMATION

If more than one screen, show locations of each on sketch.