

MISSISSIPPI DEPARTMENT OF NATURAL RESOURCES

Bureau of Land and Water Resources

Southport Mall

P.O. Box 10631

CODED

Jackson, Mississippi 39209

WATER WELL DRILLERS LOG
COASTAL DRILLING & SERVICE CO.

ROUTE 1 BOX 618

BILOXI MISS 39532

county well located

Harrison
L 618

2/8/83 19
date well completed

Harrison

LANDOWNER: Joey Cooney
St 5 P & B Lot 13
Spt Ms 39502
(mailing address)

description of formations encountered	from	to
<u>Top Soil</u>	<u>1</u>	<u>3</u>
<u>Red Clay</u>	<u>3</u>	<u>15</u>
<u>Coarse white sand</u>	<u>15</u>	<u>65</u>
<u>5 ft Blue Clay</u>	<u>65</u>	<u>270</u>
<u>fine water sand</u>	<u>270</u>	<u>290</u>
<u>Hard Blue Clay</u>	<u>290</u>	<u>410</u>
<u>fine water sand</u>	<u>410</u>	<u>440</u>
<u>Every coarse water sand</u>	<u>440</u>	<u>480</u>

WELL LOCATION:
sec. 1 T. 7 N. R. 11 E
S. W.
Ms power line
(distance) (direction) of (nearest town)

WELL PURPOSE: home
(home, irrigation, municipal, industrial)

WELL COMPLETION DATA:
(1) diameter (inches) 2"
(2) total depth (feet) 480'
(3) static water level (feet) 30' below above top of ground.
(4) casing: Pvc, 470'
(material) (depth)
(size) if telescope see back.
(5) screen: 10', 470'
(length) (depth to top)
2", Pvc
(size) (material)
(6) pump: 1/4, 13
(HP) (yield gpm)
Ele
(type power)
(7) electric log no
(yes or no)
(organization running log)

CODED

(8) how well bottom plugged
2" lead shot
DRILLERS REMARKS: 19-B


DEPT. OF NATURAL RESOURCES
BUREAU OF LAND & WATER RESOURCES

AUG 12 1983

RECEIVED

If well telescopes please sketch and show depths.

GROUND LEVEL

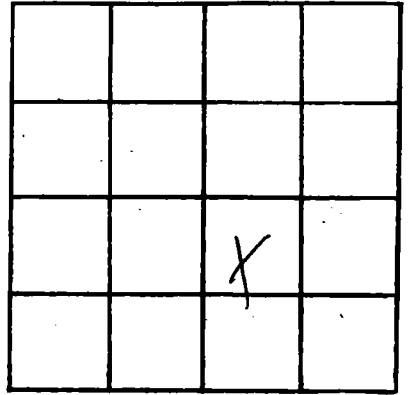

SECTION _____

Please indicate well location X.

ADDITIONAL INFORMATION

If more than one screen, show locations of each on sketch.