

Harrison
 L627

MISSISSIPPI
 BOARD OF WATER COMMISSIONERS
 416 North State Street
 Jackson, Mississippi 39201

CODED

WATER WELL DRILLERS LOG

6-28-83 19

R. J. Moore Well Driller

HARRISON

date well completed

firm name

county well located

LANDOWNER: G. R. Belote
 ROUND HILL FARM
 RT #1 Box 97

description of formations
 encountered

from

to

LANDON RD GULFOOD, MS
 (mailing address)

TOP SOIL

0 10

Coarse white sand

10 16

Blue white clay

16 40

SILT SAND

40 80

Blue clay

80 390

Med sand

390 460

Coarse sand

460 410

Coarse sand with

small gravel

410 440

WELL LOCATION:

sec. 8 T 7 N R 11 E
 5 miles N of GULFOOD
 (distance) (direction) (nearest town)

WELL PURPOSE: FARM
 (home, irrigation, municipal, industrial)

WELL COMPLETION DATA:

- (1) diameter (inches) 2"
- (2) total depth (feet) 440'
- (3) static water level (feet) 45' below above top of ground.
- (4) casing PVC, 430' (material), (depth)
 2" (size) if telescope see back.
- (5) screen 10', 430' (length), (depth to top)
 2" (size), PVC (material)
- (6) pump 1 (HP), 8 (yield gpm)
 E (type power)
- (7) electric log (yes or no)
 (organization running log)
- (8) how well bottom plugged S.S.

CODED

DEPT. OF NATURAL RESOURCES
 BUREAU OF LAND & WATER RESOURCES


JUL 8 1983

RECEIVED

DRILLERS REMARKS:

If well telescopes please sketch and show depths.

GROUND LEVEL

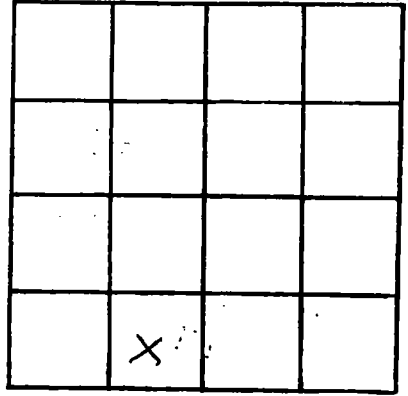

SECTION _____

Please indicate well location X.

ADDITIONAL INFORMATION

If more than one screen, show locations of each on sketch.