

**MISSISSIPPI DEPARTMENT OF NATURAL RESOURCES**  
**Bureau of Land and Water Resources**  
 Southport Mall  
 P.O. Box 10631  
 Jackson, Mississippi 39209  
**WATER WELL DRILLERS LOG**

**CODED**

Harrison  
L 629

7-18-83  
 date well completed

Mc Gill Well Works  
 firm name

HARRISON  
 county well located

**LANDOWNER:** PAUL GANTU  
P.O. BOX 3643  
GULFPORT, MS 39503  
 (mailing address)

**WELL LOCATION:**  
 sec. S4 T1 N R. 11 E  
0 miles 0 of Gulfport  
 (distance) (direction) (nearest town)

**WELL PURPOSE:**  
 (home, irrigation, municipal, industrial)

**WELL COMPLETION DATA:**

- (1) diameter (inches) 2 inches
- (2) total depth (feet) 440
- (3) static water level (feet) 60' ~~below~~ above top of ground. 40 PVC
- (4) casing Plastic, 440  
 (material) (depth)
- (size) If telescope see back.
- (5) screen 10 ft, 430  
 (length) (depth to top)
- 2" slot Plastic, 80 PVC  
 (size) (material)
- (6) pump 1 (HP)            (yield gpm)  
electric  
 (type power)
- (7) electric log NO  
 (yes or no)
- (organization running log)
- (8) how well bottom plugged shark

description of formations encountered	from	to
Mud	0	20
SAND	20	40
SAND	40	100
MUD	100	180
SAND	180	300
SAND	300	320
MUD	320	380
SAND	380	300
SAND	300	320
MUD	320	420
SAND	420	440

**CODED**

DEPT. OF NATURAL RESOURCES  
 BUREAU OF LAND & WATER RESOURCES

**AUG 10 1983**

**RECEIVED**


DRILLERS REMARKS:

If well telescopes please sketch and show depths:

GROUND LEVEL

00  
01  
02  
03  
04  
05  
06  
07  
08  
09  
10  
11  
12

01  
02  
03  
04  
05  
06  
07  
08  
09  
10  
11  
12

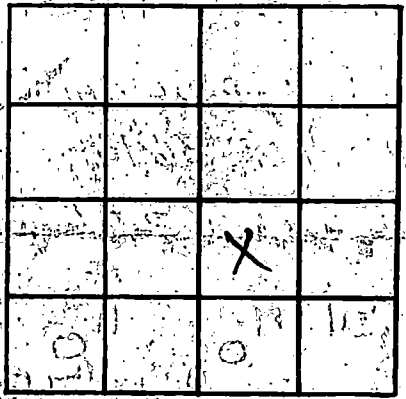

SECTION 34

Please indicate well location X.

ADDITIONAL INFORMATION

SPM  
01  
02  
03  
04  
05  
06  
07  
08  
09  
10  
11  
12

If more than one screen, show locations of each on sketch.