

MISSISSIPPI DEPARTMENT OF NATURAL RESOURCES

Bureau of Land and Water Resources

Southport Mall

P.O. Box 10631

CODED

Jackson, Mississippi 39209

WATER WELL DRILLERS LOG

HARRISON
 L 630
 4/19/82

4-19

1982 Braden Pump & Well Sr.

Harrison

date well completed

firm name

county well located

LANDOWNER: Dogwood Nursery
 Washington Ave. P.O. Box 283
 Southport Miss. 39501
 (mailing address)

description of formations encountered

from

to

Surface	0	6
White Clay	6	18
White Sand	18	32
Grey Clay	32	85
Clay Shell - Fine	85	105
Blue Clay	105	165
Clay & Sand Layers	165	340
Blue Clay	340	470
Coarse Grey Sand	470	560
		7

WELL LOCATION:

sec. 23 T 7 N R 11 W
 In miles CPT of (distance) (direction) of (nearest town)

WELL PURPOSE: Nursery
 (home, irrigation, municipal, industrial)

CODED

WELL COMPLETION DATA:

- (1) diameter (inches) 4"
- (2) total depth (feet) 560
- (3) static water level (feet) 70 below top of ground.
- (4) casing PVC 540 (material), (depth)
 4" (size) If telescope see back.
- (5) screen 20 (length), 540 (depth to top)
 4" PVC Underbar (size), (material)
- (6) pump 5 (HP), 90 (yield gpm)
 200V-1P (type power)
- (7) electric log No (yes or no)

CODED

DEPT. OF NATURAL RESOURCES
 BUREAU OF LAND & WATER RESOURCES

JAN 24 1983

RECEIVED


(organization running log)

(8) how well bottom plugged
 2" Sand Shank

DRILLERS REMARKS:

If well telescopes please sketch and show depths.

GROUND LEVEL

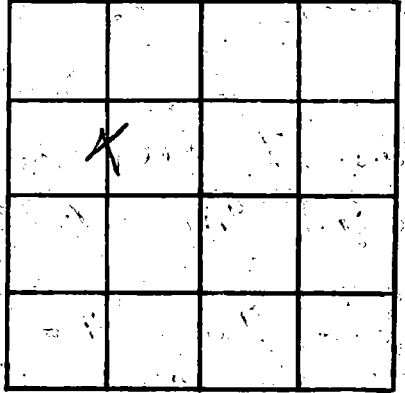

SECTION 23

Please indicate well location X.

ADDITIONAL INFORMATION

If more than one screen, show locations of each on sketch.