

MISSISSIPPI DEPARTMENT OF NATURAL RESOURCES  
 Bureau of Land and Water Resources  
 Southport Mall  
 P.O. Box 10631  
 Jackson, Mississippi 39209  
**WATER WELL DRILLERS LOG**

Harrison  
L 631  
6-24-83

**CODED**

10-24 1983 McGinn Well Works JARRISON  
 date well completed firm name county well located

LANDOWNER: McGuire Homes  
1115 Pass Road  
GDT, Ms. 39501  
 (mailing address)

description of formations encountered	from	to
<u>clay</u>	<u>0</u>	<u>200</u>
<u>sand</u>	<u>200</u>	<u>300</u>
<u>clay</u>	<u>300</u>	<u>350</u>
<u>sand</u>	<u>350</u>	<u>360</u>
<u>sand</u>	<u>360</u>	<u>380</u>
<u>sand</u>	<u>380</u>	<u>400</u>

WELL LOCATION:  
 sec 35 T 7 N R 11 E  
0 miles (distance) S (direction) of GDT (nearest town)

WELL PURPOSE: home  
 (home irrigation, municipal, industrial)


- WELL COMPLETION DATA:
- (1) diameter (inches) 2"
  - (2) total depth (feet) 400'
  - (3) static water level (feet) 65' <sup>below</sup> top of ground
  - (4) casing 400' PVC, 390' (material), (depth)
  - (size) If telescope see back.
  - (5) screen 10', 390' (length), (depth to top)
  - (size), 400' PVC (material)
  - (6) pump 1, 10 (HP), (yield gpm)
  - elec (type power)
  - (7) electric log — (yes or no)
  - (organization running log)
  - (8) how well bottom plugged seal

DRILLERS REMARKS:

DEPT. OF NATURAL RESOURCES  
 BUREAU OF LAND & WATER RESOURCES  
 JAN 17 1984  
**RECEIVED**

If well telescopes please sketch and show depths.

GROUND LEVEL

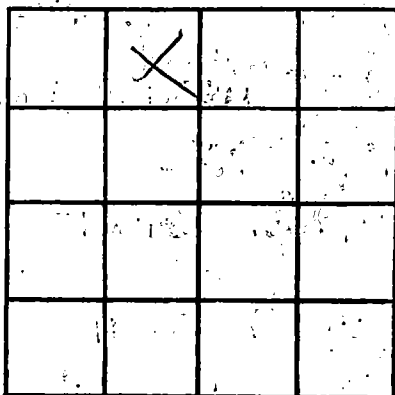

SECTION 35

Please indicate well location X.

ADDITIONAL INFORMATION

If more than one screen,  
show locations of each on sketch.