

MISSISSIPPI DEPARTMENT OF NATURAL RESOURCES

Bureau of Land and Water Resources

Southport Mall

P.O. Box 10631

Jackson, Mississippi 39209

WATER WELL DRILLERS LOG

**CODED**

L-635  
 HARRISON  
 11-30-83

11/30/83 date well completed  
 Robert Lyman Well firm name  
 Harrison county well located

LANDOWNER: Robert Campbell  
 Rt. 5, Box 657  
 Gulfport, 39503  
 (mailing address)

description of formations encountered	from	to
White clay	0	20
Blue clay	20	100
Fine sand	100	140
Clay	140	200
Good sand	200	258

WELL LOCATION:  
 sec. 36 T 1 N R 11 E  
 10 miles N of Gpt  
 (distance) (direction) (nearest town)

WELL PURPOSE: Home  
 (home, irrigation, municipal, industrial)

WELL COMPLETION DATA:

(1) diameter (inches) 24

(2) total depth (feet) 258'

(3) static water level (feet) 30 below top of ground

(4) casing PVC 248'  
 (material) (depth)  
 2" if telescope see back.  
 (size)

(5) screen 10' 248'  
 (length) (depth to top)  
 2" PVC  
 (size) (material)

(6) pump 1 14  
 (HP) (yield gpm)  
 electric  
 (type power)

(7) electric log No  
 (yes or no)  
 No  
 (organization running log)

(8) how well bottom plugged sand  
 Shark

DEPT. OF NATURAL RESOURCES  
 BUREAU OF LAND & WATER RESOURCES


APR 30 1989

**RECEIVED**

DRILLERS REMARKS:

If well telescopes please sketch and show depths.

GROUND LEVEL

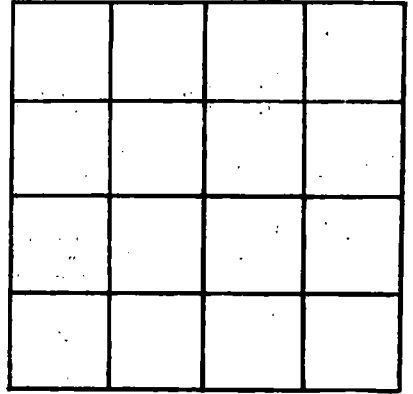

SECTION \_\_\_\_\_

Please indicate well location X.

ADDITIONAL INFORMATION

If more than one screen,  
show locations of each on sketch.