

MISSISSIPPI DEPARTMENT OF NATURAL RESOURCES

Bureau of Land and Water Resources

Southport Mall

P.O. Box 10631

Jackson, Mississippi 39209

WATER WELL DRILLERS LOG

L637  
 HARRISON  
 3-26-84

CODED

3/26 1984 Braden Pump & Well Harrison  
 date well completed firm name county well located

LANDOWNER: Cheryl Shaw  
 Box 397-B  
 Southport, Me 39563  
 (mailing address)

description of formations encountered	from	to
red clay	0	20
red clay	20	60
white sand	60	90
blue clay	90	180
brown sand	180	230
blue clay	230	240

WELL LOCATION:  
 sec. 7 T 7 S R 11 E  
 3 miles west of Lyman  
 (distance) (direction) (nearest town)

WELL PURPOSE: home  
 (home, irrigation, municipal, industrial)

- WELL COMPLETION DATA:
- (1) diameter (inches) 2"
  - (2) total depth (feet) 240
  - (3) static water level (feet) 23 below top of ground.
  - (4) casing PVC, 215 (material), (depth), 2" (size) If telescope see back.
  - (5) screen 10', 215 (length), (depth to top), 2", PVC underlain (size), (material)
  - (6) pump 1 (HP), 10 (yield gpm), 230 V (type power)
  - (7) electric log no (yes or no)

(organization running log)  
 (8) how well bottom plugged PVC sandstone

DRILLERS REMARKS: 15 ft tailpipe


DEPT. OF NATURAL RESOURCES  
 BUREAU OF LAND & WATER RESOURCES

MAY 21 1984

RECEIVED

If well telescopes please sketch and show depths.

GROUND LEVEL

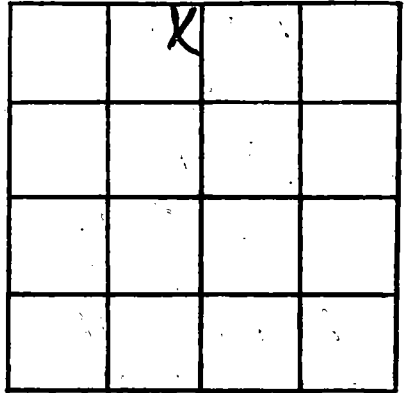

SECTION 7

Please indicate well location X.

ADDITIONAL INFORMATION

Lined area for additional information.

If more than one screen, show locations of each on sketch.