

MISSISSIPPI DEPARTMENT OF NATURAL RESOURCES
Bureau of Land and Water Resources

CODED

Southport Mall
P.O. Box 10631

Jackson, Mississippi 39209
WATER WELL DRILLERS LOG

L638
HARRISON
416-84

41-16 1984 Braden Pump Well Serv Harrison
date well completed firm name county well located

LANDOWNER: Guy H. Saenger
PO Box 3424
Gulfport MS 39503
(mailing address)

WELL LOCATION:
sec. 17 T. 7 S. R. 11 W.
6 miles north of Gulfport
(distance) (direction) (nearest town)

WELL PURPOSE: home
(home, irrigation, municipal, industrial)

- WELL COMPLETION DATA:
- (1) diameter (inches) 4x2
 - (2) total depth (feet) 560
 - (3) static water level (feet) 33 below above top of ground.
 - (4) casing PVC, 530,
(material) (depth)
4x2 if telescope see back.
(size)
 - (5) screen 10 ft, 530
(length) (depth to top)
2", PVC underbar
(size) (material)
 - (6) pump 1, 20
(HP) (yield gpm)
230V
(type power)
 - (7) electric log no
(yes or no)
- (organization running log)
- (8) how well bottom plugged PVC
sandshark

description of formations encountered	from	to
clay	0	40
clay + sand	40	60
sand	60	80
clay + sand	80	200
sand	200	240
clay	240	260
clay + sand	260	300
clay	300	340
clay + sand	340	420
clay	420	480
clay + sand	480	500
sand	500	560

DRILLERS REMARKS: 20' tail pipe

DEPT OF NATURAL RESOURCES
BUREAU OF LAND & WATER RESOURCES

MAY 21 1984

RECEIVED


If well telescopes please sketch and show depths.

GROUND LEVEL

200' 4" PVC

360' 2" PVC

2" PVC 10' screens
10' tailpipe

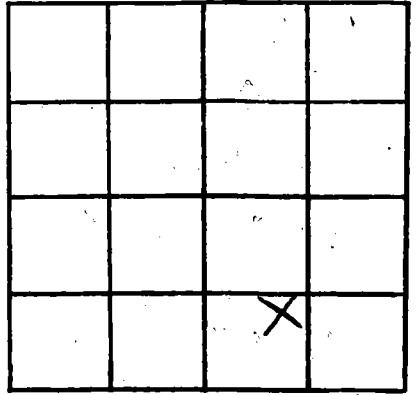

SECTION 17

Please indicate well location X.

ADDITIONAL INFORMATION

If more than one screen, show locations of each on sketch.