

1639
 HARRISON CO
 5-3-84

MISSISSIPPI
 BOARD OF WATER COMMISSIONERS
 416 North State Street
 Jackson, Mississippi 39201

CODED

WATER WELL DRILLERS LOG

5-3-84 date well completed
 R. V. McKeel Drilling firm name
 HARRISON county well located

LANDOWNER:	description of formations encountered	from	to
RYDER TRUCK RENTAL DeDeaux RD Gulfport, MS 39501 (mailing address)	Top Soil	0	10
sec 12 T 7 N R 11 E 2 miles (distance) of LORRAINE (direction) of (nearest town)	White Sand	10	30
WELL LOCATION:	Blue Clay	30	300
sec 12 T 7 N R 11 E 2 miles (distance) of LORRAINE (direction) of (nearest town)	Blue Sand	300	325
WELL PURPOSE: TRUCK WASH (home, irrigation, municipal, industrial)	Blue Clay	325	450
WELL COMPLETION DATA:	Red Sand	450	500
(1) diameter (inches) 4 X 2	CORREL SAND FINE	500	520
(2) total depth (feet) 520'	Gravel		
(3) static water level (feet) 30' below top of ground			
(4) casing PVC (material), 520 (depth)			
(5) screen 20' (length), 520 (depth to top)	240 - 4" PVC		
(6) pump 2 (HP), 35 (yield gpm)	280' - 2" PVC		
(7) electric log (yes or no)	20' - 2" PVC STRANGE		
(8) how well bottom plugged			
DRILLERS REMARKS:			


DEPT. OF NATURAL RESOURCES
 BUREAU OF LAND & WATER RESOURCES

MAY 29 1984

RECEIVED

If well telescopes please sketch and show depths.

GROUND LEVEL

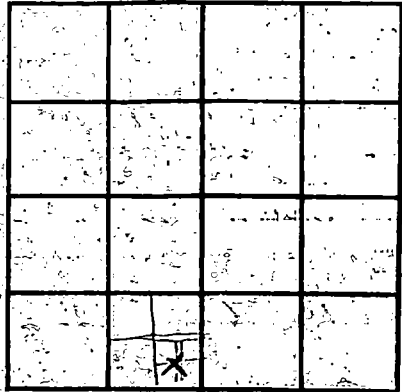

SECTION _____

Please indicate well location X.

ADDITIONAL INFORMATION

If more than one screen, show locations of each on sketch.