

MISSISSIPPI DEPARTMENT OF NATURAL RESOURCES

Bureau of Land and Water Resources

Southport Mall

P.O. Box 10631

CODED

Jackson, Mississippi 39209

WATER WELL DRILLERS LOG

HARRISON  
L 642  
5/22/84

5/22/84  
date well completed

Lyman Well Co.  
firm name

Harrison  
county well located

LANDOWNER:

Weatherly Gen. Cont.

Description of formations encountered

from to

P.O. Box 2653  
Southport 39503  
(mailing address)

White Sand & Clay	0	50
White & Blue Clay	50	200
Blue Clay	200	340
Fine Sand	340	375
Blue Clay	375	454
Fine Sand	450	500
Blue Clay	500	544
Good Sand	544	592

WELL LOCATION:

sec. 33 T. 7 N. R. 11 E  
12 miles N/E of GAT.  
(distance) (direction) (nearest town)

WELL PURPOSE:

(home, irrigation, municipal, industrial)

WELL COMPLETION DATA:

- (1) diameter (Inches) 4x2
- (2) total depth (feet) 592'
- (3) static water level (feet) 60' below top of ground.
- (4) casing PVC, 572'  
(material) (depth)  
4x2 if telescope see back.  
(size)
- (5) screen 2", 572'  
(length) (depth to top)  
2", PVC  
(size) (material)
- (6) pump 1/2, 35  
(HP) (yield gpm)  
electric  
(type power)
- (7) electric log No  
(yes or no)  
No  
(organization running log)
- (8) how well bottom plugged sand Shark

CODED


DEPT. OF NATURAL RESOURCES  
BUREAU OF LAND & WATER RESOURCES

SEP - 5 1984

RECEIVED

DRILLERS REMARKS:

If well telescopes please sketch and show depths.

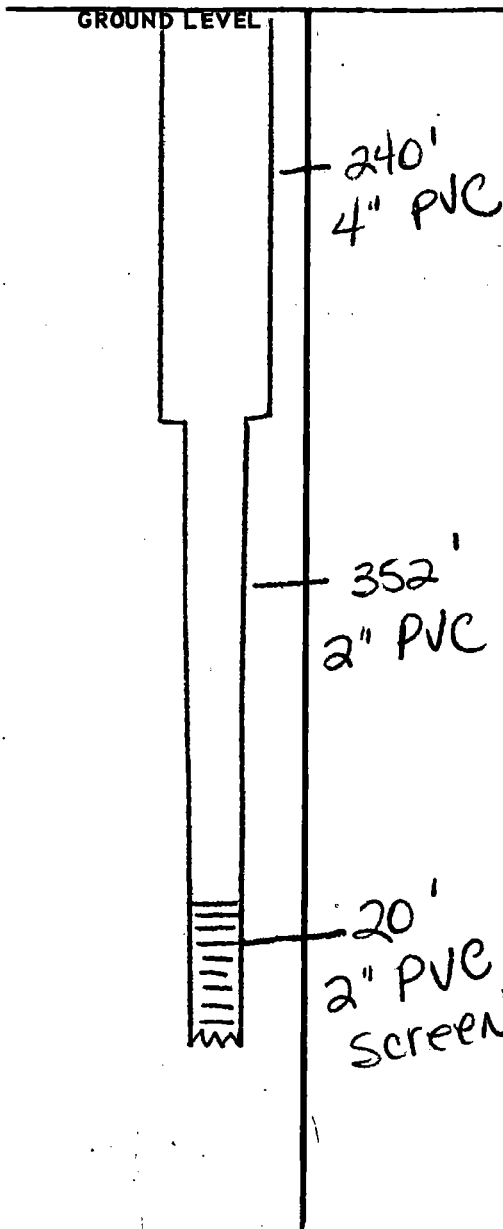

			X

SECTION 33

Please indicate well location X.

ADDITIONAL INFORMATION

---

---

If more than one screen, show locations of each on sketch.