

MISSISSIPPI DEPARTMENT OF NATURAL RESOURCES

Bureau of Land and Water Resources

Southport Mall

P.O. Box 10631

CODED

Jackson, Mississippi 39209

WATER WELL DRILLERS LOG

2653
Harrison
9-14-84

9/14/84 19 Lyman Well Co. Harrison
date well completed firm name county well located

LANDOWNER: Pat Beasley
Dedeaux Rd.
Southport, Ms
(mailing address)

WELL LOCATION:
sec. 9 T. 7 N R. 11 E
5 miles N of Spt
(distance) (direction) (nearest town)

WELL PURPOSE: Home
(home, irrigation, municipal, industrial)

WELL COMPLETION DATA:

(1) diameter (inches) 2"

(2) total depth (feet) 442'

(3) static water level (feet) 30' below top of ground.

(4) casing PVC, 432'
(material) (depth)
2" If telescope see back.
(size)

(5) screen 10', 432'
(length) (depth to top)
2", PVC
(size) (material)

(6) pump 1 12
(HP) (yield gpm)
electric
(type power)

(7) electric log No
(yes or no)
No
(organization running log)

(8) how well bottom plugged sand
shark

description of formations encountered	from	to
Red clay mud	0	20
Red clay mud	20	40
Red clay mud	40	60
Red mud	60	80
White sand	80	100
Red clay mud	100	120
Red clay mud	120	140
Red clay mud	140	160
Red clay mud	160	180
Red clay mud	180	200
Blue clay mud	200	220
Blue clay mud	220	240
Blue clay mud	240	260
Blue clay mud	260	280
Blue clay mud	280	300
Blue clay mud	300	320
Blue clay mud	320	340
Blue clay mud	340	360
Blue clay	360	380
Blue clay	380	400
Blue sand	400	420
Blue sand	420	442

DEPT. OF NATURAL RESOURCES
BUREAU OF LAND & WATER RESOURCES


DEC 10 1984

RECEIVED

DRILLERS REMARKS:

If well telescopes please sketch and show depths.

GROUND LEVEL

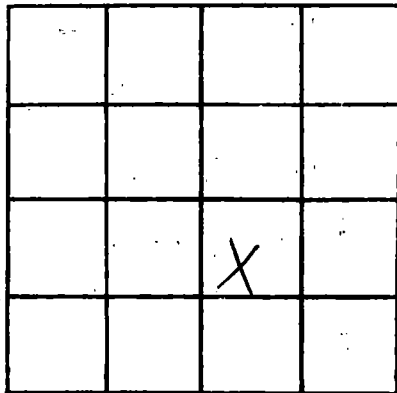

SECTION 9

Please indicate well location X.

ADDITIONAL INFORMATION

If more than one screen, show locations of each on sketch.