

MISSISSIPPI DEPARTMENT OF NATURAL RESOURCES

Bureau of Land and Water Resources

Southport Mall

P.O. Box 10631

Jackson, Mississippi 39209

WATER WELL DRILLERS LOG

CODED

Harrison
L 657
2/2/85

2/2/85 19 Lyman Well Co. Harrison
date well completed firm name county well located

LANDOWNER	Description of formations encountered	from	to
Michael Thurgood Rt. 11, Box 67 Gulfport, Md 39503 (mailing address)	Red clay Blue clay Coarse sand	0	60 60 220 248

WELL LOCATION:

sec. 8 T. 7 N. R. 11 E.
3 miles with west Gulfport
(distance) (direction) (nearest town)

WELL PURPOSE: none
(home, irrigation, municipal, industrial)

WELL COMPLETION DATA:

- (1) diameter (inches) 2
- (2) total depth (feet) 248'
- (3) static water level (feet) 14 feet ^{below} top of ground.
- (4) casing PVC, 238'
(material) (depth)
2" (size) If telescope see back.
- (5) screen 10', 238'
(length) (depth to top)
2" (size) PVC (material)
- (6) pump 1 (HP) 12 (yield gpm)
electric (type power)
- (7) electric log No
(yes or no)
NO (organization running log)
- (8) how well bottom plugged sand
shark

CODED

RECEIVED


MAY 24 1985

Department of Natural Resources
Bureau of Land & Water Resources

DRILLERS REMARKS:

If well telescopes please sketch and show depths.

GROUND LEVEL

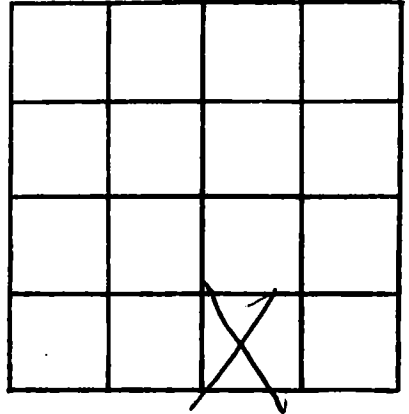

SECTION 8

Please indicate well location X.

ADDITIONAL INFORMATION

If more than one screen, show locations of each on sketch.