

MISSISSIPPI
 BOARD OF WATER COMMISSIONERS
 416 North State Street
 Jackson, Mississippi 39201

CODED

WATER WELL DRILLERS LOG

HARRISON
L660
7-30-85
GW 01888

7-30 1985 date well completed
 Layne Central Co. firm name
 Harrison county well located

LANDOWNER: Medcoy Utilities
522 Pass Road
Myrtle, MS 39501
 (mailing address)

description of formations encountered	from	to
Top Soil	0'	5'
red clay	5'	25'
blue clay	25'	182'
sandy clay	182'	272'
clay	272'	580'
sandy clay	580'	605'
sand	605'	630'
clay	630'	670'
sand	670'	760'
clay	760'	774'

WELL LOCATION:
 sec. 12 T. 7 N. R. 11 E.
 (distance) (direction) (nearest town)

WELL PURPOSE:
 (home, irrigation, municipal, industrial)

WELL COMPLETION DATA:

(1) diameter (inches) 12"

(2) total depth (feet) 751'

(3) static water level (feet) 56' below above top of ground.

(4) casing Steel, 690',
 (material) (depth)
12" If telescope see back.
 (size) 64" 4" of 8"

(5) screen 51', 690'
 (length) (depth to top)
8", 5. Steel
 (size) (material)

(6) pump 50 600
 (HP) (yield gpm)
Electric
 (type power)

(7) electric log Yes
 (yes or no)
Layne Central Co.
 (organization running log)

(8) how well bottom plugged B.P. Valve

620
 5/1
 74



RECEIVED
 MAR 10 1986

Department of Natural Resources
 Bureau of Land & Water Resources

DRILLERS REMARKS: Requested Permit # from Legislature - no response

If well telescopes please sketch and show depths.

GROUND LEVEL

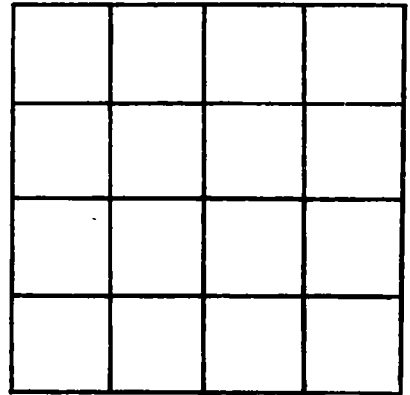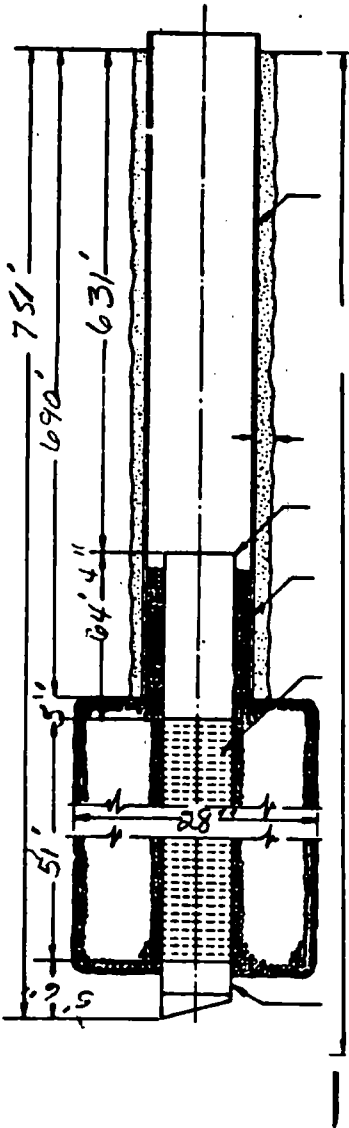

SECTION _____

Please indicate well location X.

ADDITIONAL INFORMATION

If more than one screen, show locations of each on sketch.