

Harrison
L 244
715

MISSISSIPPI
BOARD OF WATER COMMISSIONERS
416 North State Street
Jackson, Mississippi 39201

WATER WELL DRILLERS LOG

10-17-86 19 R. J. Moore HARRIS 014
date well completed firm name county well located

LANDOWNER: PAUL STANNETT
Stinnett
CANAL RD
Coulspond, MS
(mailing address)

WELL LOCATION:
sec. 8 T. 7 N. R. 11 E.
4 miles W of NUGENT
(distance) (direction) (nearest town)

WELL PURPOSE:
(home, irrigation, municipal, industrial)

- WELL COMPLETION DATA:
- (1) diameter (inches) 2"
 - (2) total depth (feet) 580'
 - (3) static water level (feet) 50' below above top of ground.
 - (4) casing PVC 580 510
(material) (depth)
 - (size) If telescope see back 510
 - (5) screen 10' 580
(length) (depth to top)
 - (size) 2" PVC
(size) (material)
 - (6) pump 1 8
(HP) (yield gpm)
 - (type power) E
 - (7) electric log —
(yes or no)
 - (organization running log)
 - (8) how well bottom plugged BULLWORM

description of formations encountered	from	to
TOP SOIL	0	20
White Clay	20	60
Blue Clay	60	120
Red Sand	120	160
Blue Clay	160	500
FINE SAND	500	540
Med Sand	540	560
CORSE SAND	560	580


RECEIVED
JAN 02 1987

Department of Natural Resources
Bureau of Land & Water Resources

DRILLERS REMARKS:

If well telescopes please sketch and show depths.

GROUND LEVEL

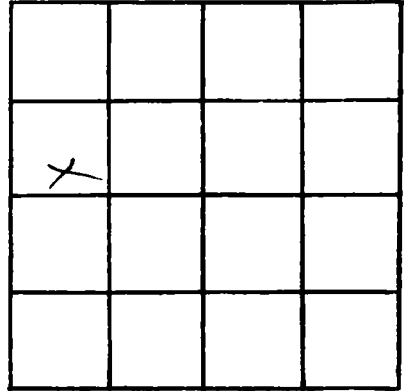

SECTION 5

Please indicate well location X.

ADDITIONAL INFORMATION

If more than one screen, show locations of each on sketch.