

MISSISSIPPI DEPARTMENT OF ENVIRONMENTAL QUALITY

Office of Land and Water Resources

P. O. Box 10631

Jackson, MS 39289-0631

WATER WELL DRILLERS LOG

COUNTY WELL LOCATED HARRISON	
WELL NUMBER L 125	CODED <input checked="" type="checkbox"/>
DATE WELL COMPLETED 4-25-98	

PERMIT NUMBER 0404 GW-15316
NAME OF DRILLING FIRM LYMAN WELL Co.
GULFPORT, MS 39503

NAME & MAILING ADDRESS OF LANDOWNER City of Gulfport OGG 4050 Hanes Ave P.O. BOX 2969			
GULFPORT, MS 39503			
WELL LOCATION	SEC	TOWNSHIP	RANGE
	6	7 N	11 E
DISTANCE	DIRECTION	NEAREST TOWN	
IN Miles	City	of Gulfport	
OTHER LANDMARK			
WELL PURPOSE Home, Irrigation, Municipal, Industrial, Fish Pond, etc. STIGlets Rd.			

PUMP DATA		
PUMP TYPE (Circle One): Submersible, <u>Turbine</u> Jet Flowing Well, Other (Describe) _____		
POWER TYPE (Circle One): Electric, Tractor, Diesel, Gasoline, Butane, Other (Describe) _____ H/P _____		
Pump Capacity (GPM) 800	No. of Stages 5	Setting Depth 140 FT.
PUMP TEST		
Well yielded 800 GPM with a drawdown of 29 ft. after 8 hours of pumping		

WELL DATA		
Well Depth 710	Casing Diameter (In.) 12"	Casing Length (Ft.) 635
Type of Casing steel	Hole Depth 710	Depth to Static Water Level 92'

LOG DATA	
TYPE OF LOG RUN (Circle One): <u>Electric</u> , <u>Gamma Ray</u> , Density, Sonic, Neutron, Other (Describe) _____	
Name of Organization Running Log state	

TYPE OF COMPLETION: (Circle One or More): Gravel Packed, <u>Underreamed</u> , Telescoped, Natural Development, Open Hole, Other (Describe) _____			
WELL GROUTED TO A DEPTH OF 835 FEET Type Grout (circle one) <u>Cement</u> , Bentonite, or Mix			

GEOLOGIC DATA (Office Use Only)			
Surface Elev.	Geologic Unit	Unit Thickness	Depth to Top
Subs. SWL	Date	Analysis	Aquifer Test

SCREEN DATA		
Diameter - Inches 8"	Length - Feet 60'	Slot Size - Inches .10
Screen Type SS	Depth to Bottom - Feet 710	


Driller's Remarks	
Top of Lap Pipe or Reduction in Casing 570 FEET	
IF TELESCOPED OR MORE THAN ONE SCREEN: USE BACK PAGE	

DESCRIPTION OF FORMATIONS ENCOUNTERED	FROM	TO
yellow sand clay	0	60
yellow clay	60	150
yellow sand	150	181
grey clay	181	220
grey sand	220	255
Blue clay	255	495
sand	495	595
Blue clay	595	636
sand	636	710

FORMATIONS (Continued)	FROM	TO
RECEIVED		
NOV 20 1998		
Dept. of Environmental Quality Office of Land & Water Resources		
IF MORE SPACE IS NEEDED. USE BACK		

If well telescopes please sketch and show depths.

GROUND LEVEL

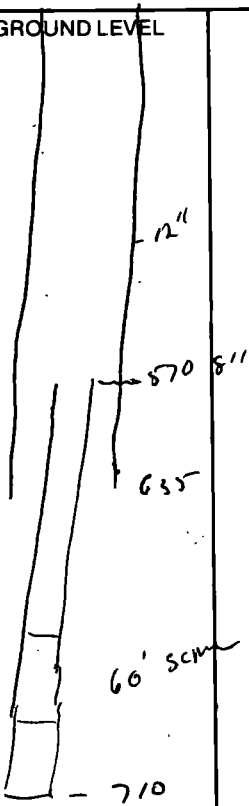

		X	

SECTION _____

Please indicate well location X.

ADDITIONAL INFORMATION

Multiple horizontal lines for entering additional information.

RECEIVED
SEP 11 2 00 PM '88

Office of Land & Water Resources
Department of Environmental Quality

If more than one screen,
show location of each on sketch.