

L
Harrison
L-741

WATER WELL DRILLERS LOG

Date: Jan 31, 1966, Driller: Joe Miller County Harrison
(Name)

(1) Owner of Land: J B Lee
(Name)
RRA Sullfort Miss
(Address)

(2) Location: 1/4, 1/4, Sec. 17 E R11 W
5 miles NE, of Sullfort
(distance) (direction) (Nearest Town)

(3) Topography: Flat
(Hilly) (Flat) (Level)

(4) Purpose of Well: Domestic
(Domestic Irrigation
Municipal, Industrial, Other)

Description & Color of Materials Sand, Clay, Red Clay, Shell, etc.	Thick- ness Feet	Depth Feet
Surface	3	3
Hd Red, Yellow Clay	12	15
Coarse Sand, Loose	25	40
Soft Ch + Sand Mix	40	80
White Clay	10	90
Blue Clay	170	260
Gray Sd, Fine	22	282
Blue Clay, Hd.	73	365
Gray Sd.	4	369
Sd Break + Clay	10	379
Gray Sd. Fine	10	389
" " Little Beller	11	400
" " Same	9	409
Hard Blue Ch	3	412
5' Full Run		
Made Well With		
8' slot Strainer		
Sanded, Set 100 Gauge		
Inside doing OK,		

Information upon completion of well:

(1) Diameter 2" inches.

(2) Total Depth 412' feet.

(3) Water Level 20' feet below top of ground.

(4) Cased to 399, Size 2"

(5) Screen: Size 2", Length 10'


(6) Were any formations sealed against pollution?

yes, yes, no.

If YES depth of formation 10'

Who 9

Drillers Remarks:

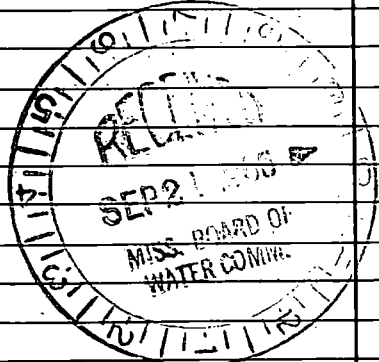

over.

(Use Back Side)

Well No.

N

Sulfent,

S

Deaudeax Ra

Three Rivers Rd

